

1 LOCATION OF WATER WELL: Fraction sw 1/4 sw 1/4 se 1/4 Section Number 24 Township Number 27s Range Number 1 E/W
 County: Sedgwick

Distance and direction from nearest town or city street address of well if located within city?
3120 W Burton

2 WATER WELL OWNER: Robert Rothhammer

RR#, St. Address, Box #: 3120 W Burton

City, State, ZIP Code: Wichita, Ks 67235

Global Positioning System (decimal degrees, min. of 4 digits)

Latitude: _____

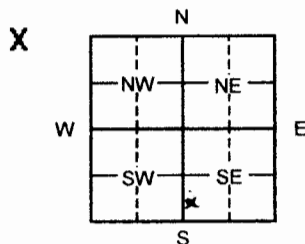
Longitude: _____

Elevation: _____

Datum: _____

Data Collection Method: _____

3 MARK WELL'S LOCATION WITH AN "X" IN SECTION BOX:

4 DEPTH OF WELL 26 ft.

WELL'S STATIC WATER LEVEL 10 ft

WELL WAS USED AS:

☒ 1 Domestic

☐ 2 Irrigation

☐ 3 Feedlot

☐ 4 Industrial

☐ 5 Public Water Supply

☐ 6 Oil Field Water Supply

☐ 7 Domestic (Lawn & Garden)

☐ 8 Air Conditioning

☐ 9 Dewatering

☐ 10 Monitoring

☐ 11 Injection Well

☐ 12 Other _____

Was a chemical/bacteriological sample submitted to Department? Yes ___ No x

5 TYPE OF BLANK CASING USED:

☒ 1 Steel

☐ 3 RMP (SR)

☐ 5 Wrought

☐ 7 Fiberglass

☐ 9 Other (Specify below) _____

☐ 2 PVC

☐ 4 ABS

☐ 6 Asbestos-Cement

☐ 8 Concrete Tile

Blank casing diameter 1 1/4 in. Was casing pulled? Yes ___ No x If yes, how much _____

Casing height above or below land surface 36 in.

6 GROUT PLUG MATERIAL: ☐ 1 Neat cement ☐ 2 Cement grout ☒ 3 Bentonite ☐ 4 Other _____

Grout Plug Intervals: From 26 ft. to 3 ft., From _____ ft. to _____ ft., From _____ to _____ ft.

What is the nearest source of possible contamination:

☐ 1 Septic tank

☐ 6 Seepage pit

☐ 11 Fuel Storage

☐ 16 Other (specify below) _____

☒ 2 Sewer line

☐ 7 Pit privy

☐ 12 Fertilizer storage

☐ 3 Watertight sewer lines

☐ 8 Sewage lagoon

☐ 13 Insecticide storage

☐ 4 Lateral lines

☐ 9 Feedyard

☐ 14 Abandoned water well

Direction from well? South

☐ 5 Cess pool

☐ 10 Livestock pens

☐ 15 Oil well/Gas well

How many feet? 15ft

FROM	TO	PLUGGING MATERIALS	FROM	TO	PLUGGING MATERIALS
<u>26</u>	<u>3</u>	<u>Bentonite</u>			
<u>3</u>	<u>0</u>	<u>Cement</u>			

7 CONTRACTOR'S OR LANDOWNER'S CERTIFICATION: This water well was plugged under my jurisdiction and was completed on (mo/day/year) 10-5-07 and this record is true to the best of my knowledge and belief. Kansas Water Well Contractor's License No. 740. This Water Well Record was completed on (mo/day/year) 10-15-07 under the business name of Weninger Drilling Inc. by (signature) _____

INSTRUCTIONS: Please fill in blanks or circle the correct answers. Send top three copies to Kansas Department of Health and Environment, Bureau of Water, Geology Section, 1000 SW Jackson St., Ste. 420, Topeka, Kansas 66612-1367. Telephone: 785/296-5522. Send one to Water Well Owner and retain one for your records. Visit us at <http://www.kdheks.gov/waterwell>.