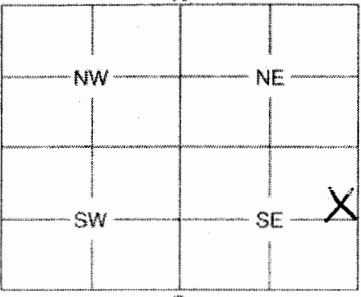


1	LOCATION OF WATER WELL: Sedgwick	Fraction SE $\frac{1}{4}$ NE $\frac{1}{4}$ SE $\frac{1}{4}$	Section Number 24	Township Number 27S	Range Number 1W
---	--	--	-----------------------------	-------------------------------	---------------------------

Distance and direction from nearest town or city street address of well if located within city?

2510 W. Douglas, Wichita, Ks

2	WATER WELL OWNER: Wichita QT #371	
	RR #, St. Address, Box #: 4705 S. 129th East Ave	Board of Agriculture, Division of Water Resources
	City, State, ZIP Code : Tulsa, OK 74134	Application Number:

3	MARK WELL'S LOCATION WITH AN "X" IN SECTION BOX: 	4	DEPTH OF WELL 24 ft. WELL'S STATIC WATER LEVEL ft. WELL WAS USED AS: <table border="0"> <tr> <td>1 Domestic</td> <td>5 Public Water Supply</td> <td>9 Dewatering</td> </tr> <tr> <td>2 Irrigation</td> <td>6 Oil Field Water Supply</td> <td><u>10</u> Monitoring Well</td> </tr> <tr> <td>3 Feedlot</td> <td>7 Domestic (Lawn & Garden)</td> <td>11 Injection Well</td> </tr> <tr> <td>4 Industrial</td> <td>8 Air Conditioning</td> <td>12 Other</td> </tr>

Was a chemical / bacteriological sample submitted to Department? Yes No X


If yes, mo/day/yr sample was submitted

Water Well Disinfected: Yes No X

5	TYPE OF BLANK CASING USED:	
	1 Steel <u>2</u> PVC 3 RMP (SR) 4 ABS 5 Wrought 6 Asbestos-Cement 7 Fiberglass 8 Concrete Tile 9 Other (Specify below)	
	Blank casing diameter 2 in.	Was casing pulled? Yes <u>X</u> No If yes, how much
	Casing height above or below land surface in.	

6	GROUT PLUG MATERIAL:	
	1 Neat cement <u>3</u> 2 Cement grout 3 Bentonite 4 Other Surface silts and clays	
	Grout Plug Intervals: From 24 ft. to 1 ft.	From 1 ft. to 0 ft. From to ft.
	What is the nearest source of possible contamination:	
	1 Septic tank 2 Sewer lines 3 Watertight sewer lines 4 Lateral lines 5 Cess pool 6 Seepage pit 7 Pit privy 8 Sewage lagoon 9 Feedyard 10 Livestock pens 11 Fuel storage 12 Fertilizer storage 13 Insecticide storage 14 Abandoned water well 15 Oil well/Gas well 16 Other (specify below) <u>Cont. site</u>	
	Direction from well?	How many feet?

FROM	TO	PLUGGING MATERIALS
24	1	Bentonite
1	0	Surface silts/clays

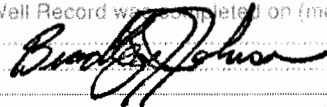7	CONTRACTOR'S OF LANDOWNER'S CERTIFICATION: This water well was plugged under my jurisdiction and was completed on (mo/day/year) 02/14/08 and this record is true to the best of my knowledge and belief. Kansas Water Well Contractor's License No. 585 This Water Well Record was completed on (mo/day/year) 02/25/08 under the business name of Associated Environmental, Inc.	
	by (signature) B. Johnson	

INSTRUCTIONS: Use typewriter or ball point pen. Please press firmly and print clearly. Please fill in blanks, underline or circle the correct answers. Send top three copies to Kansas Department of Health and Environment, Bureau of Water, Geology Section, 1000 SW Jackson St., Ste. 420, Topeka, Kansas 66612-1367. Telephone: 785/296-5522. Send one to Water Well Owner and retain one for your records.