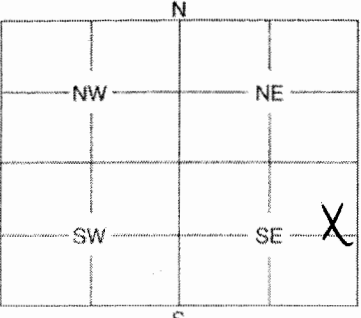


1	LOCATION OF WATER WELL:	Fraction	Section	Number	Township	Number	Range	Number
	Sedgwick	SE $\frac{1}{4}$ NE $\frac{1}{4}$ SE $\frac{1}{4}$	24		27S		1W	E/W
County: Sedgwick								

Distance and direction from nearest town or city street address of well if located within city?

2510 W. Douglas, Wichita, Ks

2	WATER WELL OWNER: Wichita QT #371
RR #, St. Address, Box #: 4705 S. 129th East Ave	
City, State, ZIP Code : Tulsa, OK 74134	
Board of Agriculture, Division of Water Resources	
Application Number:	

3	MARK WELL'S LOCATION WITH AN "X" IN SECTION BOX:	4	DEPTH OF WELL 24 ft.
		WELL'S STATIC WATER LEVEL ft.	
		WELL WAS USED AS:	
		1 Domestic 5 Public Water Supply 9 Dewatering 2 Irrigation 6 Oil Field Water Supply 10 Monitoring Well 3 Feedlot 7 Domestic (Lawn & Garden) 11 Injection Well 4 Industrial 8 Air Conditioning 12 Other	
Was a chemical / bacteriological sample submitted to Department? Yes No <u>X</u>			
If yes, mo/day/yr sample was submitted			
Water Well Disinfected: Yes No <u>X</u>			

5	TYPE OF BLANK CASING USED:
1 Steel 3 RMP (SR) 5 Wrought 7 Fiberglass 9 Other (Specify below) 2 PVC 4 ABS 6 Asbestos-Cement 8 Concrete Tile	
Blank casing diameter 2 in. Was casing pulled? Yes <u>X</u> No If yes, how much	
Casing height above or below land surface in.	

6	GROUT PLUG MATERIAL: 3 Neat cement 2 Cement grout 3 Bentonite 4 Other Surface silts and clays
Grout Plug Intervals: From 24 ft. to 1 ft. From 1 ft. to 0 ft. From to ft.	
What is the nearest source of possible contamination:	
1 Septic tank 6 Seepage pit 11 Fuel storage 12 Other (specify below) cont site 2 Sewer lines 7 Pit privy 12 Fertilizer storage 3 Watertight sewer lines 8 Sewage lagoon 13 Insecticide storage 4 Lateral lines 9 Feedyard 14 Abandoned water well 5 Cess pool 10 Livestock pens 15 Oil well/Gas well	
Direction from well? How many feet?	

FROM	TO	PLUGGING MATERIALS
24	1	Bentonite
1	0	Surface silts/clays

7	CONTRACTOR'S OF LANDOWNER'S CERTIFICATION: This water well was plugged under my jurisdiction and was completed on (mo/day/year) 02/14/08 and this record is true to the best of my knowledge and belief. Kansas Water Well Contractor's License No 585 This Water Well Record was completed on (mo/day/year) 02/25/08 under the business name of Associated Environmental, Inc. by (signature) B. Johnson
---	---

INSTRUCTIONS: Use typewriter or ball point pen. Please press firmly and print clearly. Please fill in blanks, underline or circle the correct answers. Send top three copies to Kansas Department of Health and Environment, Bureau of Water, Geology Section, 1000 SW Jackson St., Ste. 420, Topeka, Kansas 66612-1367. Telephone: 785/296-5522. Send one to Water Well Owner and retain one for your records.