

CORRECTION(S) TO WATER WELL RECORD (WWC-5)

(to rectify lacking or incorrect information)

County: Sedgwick

Location listed as:

Section-Township-Range: None Given

Fraction ($\frac{1}{4}$ $\frac{1}{4}$ $\frac{1}{4}$): _____

Location changed to:

12-275-1W

SE NE SW

Other changes: Initial statements: _____

Changed to: _____

Comments: _____

verification method: Well owner's address, city street map,
and mapping tool on KGS website.

initials: DRL date: 6/6/2008

WATER WELL PLUGGING RECORD Form WWC-5P KSA 82a-1212 ID NO.


1 LOCATION OF WATER WELL: County: Sedgewick Fraction $\frac{1}{4}$ $\frac{1}{4}$ $\frac{1}{4}$ Section Number Township Number Range Number E/W

Distance and direction from nearest town or city street address of well if located within city?

In basement.

2 WATER WELL OWNER: Clay Williams Global Positioning Systems (decimal degrees, min. of 4 digits)
 RR#, St. Address, Box #: 1538 N. Gow Latitude: _____
 City, State ZIP Code: Wichita, KS 67203 Longitude: _____
 Elevation: _____
 Datum: _____
 Data Collection Method: _____

3 MARK WELL'S LOCATION WITH AN "X" IN SECTION BOX:

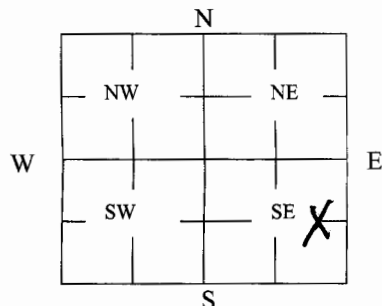

4 DEPTH OF WELL 18 ft.

WELL'S STATIC WATER LEVEL N/A ft. - Moist but no water.

WELL WAS USED AS:

- ☒ Domestic 5 Public Water Supply 9 Dewatering
 2 Irrigation 6 Oil Field Water Supply 10 Monitoring
 3 Feedlot 7 Domestic (Lawn & Garden) 11 Injection Well
 4 Industrial 8 Air Conditioning 12 Other _____

Was a chemical/bacteriological sample submitted to Department? Yes _____ No X

5 TYPE OF BLANK CASING USED:

- ☒ Steel 3 RMP (SR) 5 Wrought 7 Fiberglass 9 Other (Specify below)
 2 PVC 4 ABS 6 Asbestos-Cement 8 Concrete Tile _____

Blank casing diameter 2 in. Was casing pulled? Yes _____ No X If yes, how much _____

Casing height above or below land surface 10 in. Approx. - Cut flush to floor.

6 GROUT PLUG MATERIAL: ☒ Neat cement 2 Cement grout 3 Bentonite 4 Other _____

Grout Plug Intervals: From top ft. to bottom ft., From _____ ft. to _____ ft., From _____ to _____ ft.

What is the nearest source of possible contamination:

- 1 Septic tank 6 Seepage pit 11 Fuel Storage 16 Other (specify below)
 2 Sewer lines 7 Pit privy 12 Fertilizer storage
☒ Watertight sewer lines 8 Sewage lagoon 13 Insecticide storage
 4 Lateral lines 9 Feedyard 14 Abandoned water well Direction from well? S/W
 5 Cess pool 10 Livestock pens 15 Oil well/Gas well How many feet? 5' Approx.

FROM	TO	PLUGGING MATERIALS	FROM	TO	PLUGGING MATERIALS
<u>bottom</u>	<u>basement floor</u>	<u>Neat Cement</u>			

7 CONTRACTOR'S OR LANDOWNER'S CERTIFICATION: This water well was plugged under my jurisdiction and was completed on (mo/day/year) 5/16/08 and this record is true to the best of my knowledge and belief. Kansas Water Well Contractor's License No. N/A Home This Water Well Record was completed on (mo/day/year) 5/16/08 under the business name of N/A by (signature) Clay Williams

INSTRUCTIONS: Use typewriter or ballpoint pen. Please press firmly and print clearly. Please fill in blanks, underline or circle the correct answers. Send top three copies to Kansas Department of Health and Environment, Bureau of Water, Geology Section, 1000 SW Jackson St., Ste. 420, Topeka, Kansas 66612-1367. Telephone: 785/296-5522. Send one to Water Well Owner and retain one for your records. Visit us at <http://www.kdheks.gov/geo/waterwells>.