MW-1

# WATER WELL PLUGGING RECORD Form WWC-5P KSA 82a-1212 ID NO. 00291103

**1 LOCATION OF WATER WELL:** County: Sedgwick | Fraction: NW ¼ NW ¼ SW ¼ | Section Number: 36 | Township Number: 27 | Range Number: 1 E (W)

Distance and direction from nearest town or city street address of well if located within city?
2018 S. West Street, Wichita

**2 WATER WELL OWNER:** Brown Welding
RR#, St. Address, Box #: 2018 S. West Street
City, State ZIP Code: Wichita, KS 67213

**Global Positioning Systems** (decimal degrees, min. of 4 digits
Latitude: _____
Longitude: _____
Elevation: _____
Datum: _____
Data Collection Method:

**3 MARK WELL'S LOCATION WITH AN "X" IN SECTION BOX:**

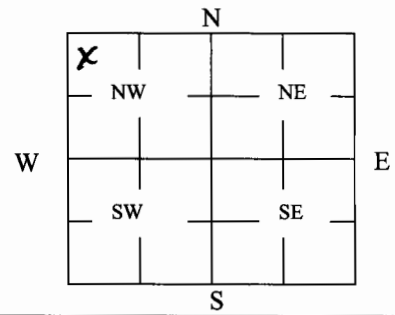


**4 DEPTH OF WELL** 20.27' ft.

WELL'S STATIC WATER LEVEL 14.06' ft

WELL WAS USED AS:

1 Domestic 5 Public Water Supply 9 Dewatering
2 Irrigation 6 Oil Field Water Supply (10) Monitoring
3 Feedlot 7 Domestic (Lawn & Garden) 11 Injection Well
4 Industrial 8 Air Conditioning 12 Other _____

Was a chemical/bacteriological sample submitted to Department? Yes _____ No X

**5 TYPE OF BLANK CASING USED:**

1 Steel 3 RMP (SR) 5 Wrought 7 Fiberglass 9 Other (Specify below)
(2) PVC 4 ABS 6 Asbestos-Cement 8 Concrete Tile _____

Blank casing diameter 2 in. Was casing pulled? Yes _____ No X If yes, how much _____
Casing height above or (below) land surface 3 in.

**6 GROUT PLUG MATERIAL:** 1 Neat cement 2 Cement grout (3) Bentonite 4 Other _____

Grout Plug Intervals: From 20.3' ft. to 0 ft., From _____ ft. to _____ ft., From _____ to _____ ft.

What is the nearest source of possible contamination:

1 Septic tank 6 Seepage pit (11) Fuel Storage 16 Other (specify below)
2 Sewer lines 7 Pit privy 12 Fertilizer storage _____
3 Watertight sewer lines 8 Sewage lagoon 13 Insecticide storage
4 Lateral lines 9 Feedyard 14 Abandoned water well Direction from well? NA - within tank basin
5 Cess pool 10 Livestock pens 15 Oil well/Gas well How many feet? 0

| FROM | TO | PLUGGING MATERIALS | FROM | TO | PLUGGING MATERIALS |
|---|---|---|---|---|---|
| 20.3' | 0' | bentonite | | | |
| | | | | | |
| Casing plugged by KDHE staff to facilitate construction at site. | | | | | |
| wellhead and top 3' of casing to be removed by construction contractor. | | | | | |
| | | | | | |
| | | | | | |
| | | | | | |

**7 CONTRACTOR'S OR LANDOWNER'S CERTIFICATION:** This water well was plugged under my jurisdiction and was completed on (mo/day/year) 02/26/08 and this record is true to the best of my knowledge and belief. Kansas Water Well Contractor's License No. —. This Water Well Record was completed on (mo/day/year) 03/21/08 under the business name of KDHE-BER by (signature) _____

**INSTRUCTIONS:** Use typewriter or ballpoint pen. Please press firmly and print clearly. Please fill in blanks, underline or circle the correct answers. Send top three copies to Kansas Department of Health and Environment, Bureau of Water, Geology Section, 1000 SW Jackson St., Ste. 420, Topeka, Kansas 66612-1367. Telephone: 785/296-5522. Send one to Water Well Owner and retain one for your records. Visit us at http://www.kdheks.gov/geo/waterwells.