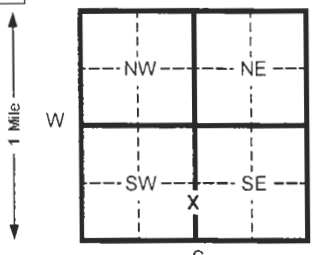


1 LOCATION OF WATER WELL:		Fraction	Section Number		Township Number		Range Number	
County:	Sedgwick	NE ¼ SE ¼ SW ¼	24	T 27S	S	R 1	W	
Distance and direction from nearest town or city street address of well if located within city? 50' N, 40' W of NE Corner of Building, 207 S. Sheridan, Mayberry Middle School - Wichita								
2 WATER WELL OWNER: USD 259								
RR#, St. Address, Box # : 3850 N. Hydraulic				Board of Agriculture, Division of Water Resources				
City, State, ZIP Code : Wichita, KS 67219				Application Number:				
3 LOCATE WELL'S LOCATION WITH AN "X" IN SECTION BOX:		4 DEPTH OF COMPLETED WELL 18 ft. ELEVATION: 1302.60 (TOC)						
		Depth(s) Groundwater Encountered 1 11.0 ft. 2 _____ ft. 3 _____ ft.						
		WELL'S STATIC WATER LEVEL 13.5 ft. below land surface measured on mo/day/yr 08/08/08						
		Pump test data: Well water was _____ ft. after _____ hours pumping _____ gpm						
		Est. Yield _____ gpm: Well water was _____ ft. after _____ hours pumping _____ gpm						
		Bore Hole Diameter 8.25 in. to 18 ft. and _____ in. to _____ ft.						
		WELL WATER TO BE USED AS: 5 Public water supply 8 Air conditioning 11 Injection well						
		1 Domestic 3 Feed lot 6 Oil field water supply 9 Dewatering 12 Other (Specify below)						
		2 Irrigation 4 Industrial 7 Lawn and garden (domestic) 10 Monitoring well						
		Was a chemical/bacteriological sample submitted to Department? Yes _____ No X If yes, mo/day/yr sample was submitted _____						
		Water Well Disinfected? Yes _____ No X						
5 TYPE OF BLANK CASING USED:								
1 Steel		3 RMP (SR)		5 Wrought Iron		8 Concrete tile		
2 PVC		4 ABS		6 Asbestos-Cement		9 Other (specify below)		
				7 Fiberglass		CASING JOINTS: Glued _____ Clamped _____		
						Welded _____		
						Threaded Flush		
Blank casing diameter 2 in. to 8 ft., Dia _____ in. to _____ ft., Dia _____ in. to _____ ft.								
Casing height above land surface Flush in., weight 0.703 lbs./ft. Wall thickness or gauge No. SCH. 40								
TYPE OF SCREEN OR PERFORATION MATERIAL:								
1 Steel		3 Stainless steel		5 Fiberglass		8 RMP (SR)		
2 Brass		4 Galvanized steel		6 Concrete tile		9 ABS		
						11 Other (specify) _____		
						12 None used (open hole)		
SCREEN OR PERFORATION OPENINGS ARE:								
1 Continuous slot		3 Mill slot		5 Gauzed wrapped		8 Saw cut		
2 Louvered shutter		4 Key punched		6 Wire wrapped		9 Drilled holes		
				7 Torch cut		10 Other (specify) _____		
						11 None (open hole)		
SCREEN-PERFORATED INTERVALS:								
From 8 ft. to 18 ft.		From _____ ft. to _____ ft.		From _____ ft. to _____ ft.		From _____ ft. to _____ ft.		
From _____ ft. to _____ ft.		From _____ ft. to _____ ft.		From _____ ft. to _____ ft.		From _____ ft. to _____ ft.		
GRAVEL PACK INTERVALS:								
From 7 ft. to 18 ft.		From _____ ft. to _____ ft.		From _____ ft. to _____ ft.		From _____ ft. to _____ ft.		
From _____ ft. to _____ ft.		From _____ ft. to _____ ft.		From _____ ft. to _____ ft.		From _____ ft. to _____ ft.		
6 GROUT MATERIAL:								
1 Neat cement		2 Cement grout		3 Bentonite		4 Other _____		
Grout Intervals From 1 ft. to 7 ft.		From _____ ft. to _____ ft.		From _____ ft. to _____ ft.		From _____ ft. to _____ ft.		
What is the nearest source of possible contamination:								
1 Septic tank		4 Lateral lines		7 Pit privy		10 Livestock pens		
2 Sewer lines		5 Cess pool		8 Sewage lagoon		11 Fuel storage		
3 Watertight sewer lines		6 Seepage pit		9 Feedyard		12 Fertilizer storage		
						13 Insecticide storage		
						14 Abandoned water well		
						15 Oil well/ Gas well		
						16 Other (specify below) _____		
Direction from well? _____ How many feet? _____								
7 CONTRACTOR'S OR LANDOWNER'S CERTIFICATION: This water well was (1) constructed , (2) reconstructed, or (3) plugged under my jurisdiction and was completed on (mo/day/yr) 08/15/08 and this record is true to the best of my knowledge and belief. Kansas								
Water Well Contractor's License No. 531				This Water Well Record was completed on (mo/day/yr) 09/17/08				
under the business name of Geotechnical Services Inc.				by (signature) _____				
INSTRUCTIONS: Please fill in blanks and circle the correct answers. Send three copies to Kansas Department of Health and Environment, Bureau of Water, 1000 S W Jackson St., Ste. 420, Topeka, Kansas 66612-1367. Telephone: 913-296-5545. Send one to WATER WELL OWNER and retain one for your records.								

SEC