

WATER WELL PLUGGING RECORD Form WWC-5P

KSA 82a-1212

ID NO.

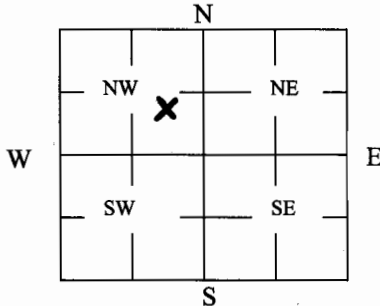
1 LOCATION OF WATER WELL: Fraction NW Section Number 28 Township Number 27 S Range Number 1 W E/W
 County: Sedgwick

Distance and direction from nearest town or city street address of well if located within city?

1255 S. Tyler Wichita KS 67212

2 WATER WELL OWNER: Kevin J. Brady ET AL Global Positioning Systems (decimal degrees, min. of 4 digits)
 RR#, St. Address, Box #: 1255 S Tyler Latitude: _____
 City, State ZIP Code: Wichita, KS 67212 Longitude: _____
 Elevation: _____
 Datum: _____
 Data Collection Method: _____

3 MARK WELL'S LOCATION WITH AN "X" IN SECTION BOX:

4 DEPTH OF WELL 30 ft.WELL'S STATIC WATER LEVEL 3 ft

WELL WAS USED AS:

1 Domestic

2 Irrigation

3 Feedlot

4 Industrial

5 Public Water Supply

6 Oil Field Water Supply

7 Domestic (Lawn & Garden)

8 Air Conditioning

9 Dewatering

10 Monitoring

11 Injection Well

12 Other _____

Was a chemical/bacteriological sample submitted to Department? Yes _____ No X

5 TYPE OF BLANK CASING USED:

1 Steel

3 RMP (SR)

5 Wrought

7 Fiberglass

9 Other (Specify below) _____

2 PVC

4 ABS

6 Asbestos-Cement

8 Concrete Tile

Blank casing diameter 5 in. Was casing pulled? Yes _____ No X If yes, how much _____Casing height above or below land surface 0 in. Level with concrete slab6 GROUT PLUG MATERIAL: 1 Neat cement 2 Cement grout 3 Bentonite 4 Other SandGrout Plug Intervals: From 30 ft. to 27 ft., From 27 ft. to 0 ft., From 0 to 3 in.

What is the nearest source of possible contamination:

1 Septic tank

6 Seepage pit

11 Fuel Storage

16 Other (specify below) _____

2 Sewer lines

7 Pit privy

12 Fertilizer storage

3 Watertight sewer lines

8 Sewage lagoon

13 Insecticide storage

4 Lateral lines

9 Feedyard

14 Abandoned water well

Direction from well? WEST

5 Cess pool

10 Livestock pens

15 Oil well/Gas well

How many feet? 235 ft

FROM	TO	PLUGGING MATERIALS	FROM	TO	PLUGGING MATERIALS
<u>30'</u>	<u>27'</u>	<u>SAND</u>			
<u>27'</u>	<u>0</u>	<u>Bentonite</u>			
<u>0</u>	<u>3"</u>	<u>Cement Grout</u>			

7 CONTRACTOR'S OR LANDOWNER'S CERTIFICATION: This water well was plugged under my jurisdiction and was completed on (mo/day/year) 9-4-2008 and this record is true to the best of my knowledge and belief. Kansas Water Well Contractor's License No. None. This Water Well Record was completed on (mo/day/year) 10-2-08 under the business name of Kevin J. Brady ET AL by (signature) Kevin J. Brady

INSTRUCTIONS: Use typewriter or ballpoint pen. Please press firmly and print clearly. Please fill in blanks, underline or circle the correct answers. Send top three copies to Kansas Department of Health and Environment, Bureau of Water, Geology Section, 1000 SW Jackson St., Ste. 420, Topeka, Kansas 66612-1367. Telephone: 785/296-5522. Send one to Water Well Owner and retain one for your records. Visit us at <http://www.kdheks.gov/geo/waterwells>.