WATER WELL RECORD Form WWC-5 KSA 82a-1212 ID No.

LOCATION OF WATER WELL: County: Sedgwick | Fraction: SW ¼ NE ¼ SE ¼ | Section Number: 25 | Township Number: T 27 S | Range Number: R 1 E/W

Distance and direction from nearest town or city street address of well if located within city?
1130 S. GORDON - Wichita, KS

WATER WELL OWNER: Gene Guinn
RR#, St. Address, Box # : 1130 S. Gordon
City, State, ZIP Code : Wichita Ks 67213

Board of Agriculture, Division of Water Resource Application Number

LOCATE WELL'S LOCATION WITH AN "X" IN SECTION BOX:

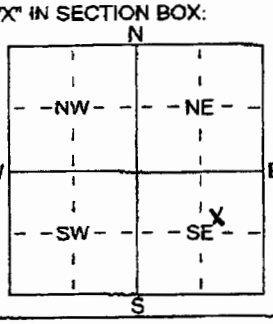

4 DEPTH OF COMPLETED WELL 25' ft. ELEVATION:
Depth(s) Groundwater Encountered 1 15ft ft. 2 ft. 3 ft.
WELL'S STATIC WATER LEVEL 15ft ft. below land surface measured on mo/day/yr 6/25/07
Pump test data: Well water was ft. after hours pumping gpm
Est. Yield gpm: Well water was ft. after hours pumping gpm
WELL WATER TO BE USED AS: 1 Domestic 2 Irrigation 3 Feedlot 4 Industrial 5 Public water supply 6 Oil field water supply 7 Domestic (lawn & garden) 8 Air conditioning 9 Dewatering 10 Monitoring well 11 Injection well 12 Other (Specify below)

Was a chemical/bacteriological sample submitted to Department? Yes ..... No X; If yes, mo/day/yrs sample was submitted
Water Well Disinfected? Yes No

TYPE OF BLANK CASING USED: 1 Steel 2 PVC 3 RMP (SR) 4 ABS 5 Wrought iron 6 Asbestos-Cement 7 Fiberglass 8 Concrete tile 9 Other (specify below)
CASING JOINTS: Glued Clamped Welded Threaded

Blank casing diameter 5 in. to ft., Dia in. to ft., Dia in. to ft
Casing height above land surface in., weight lbs./ft. Wall thickness or guage No.

TYPE OF SCREEN OR PERFORATION MATERIAL: 1 Steel 2 Brass 3 Stainless Steel 4 Galvanized Steel 5 Fiberglass 6 Concrete tile 7 PVC 8 RMP (SR) 9 ABS 10 Asbestos-Cement 11 Other (Specify) 12 None used (open hole)

SCREEN OR PERFORATION OPENINGS ARE: 1 Continuous slot 2 Louvered shutter 3 Mill slot 4 Key punched 5 Guazed wrapped 6 Wire wrapped 7 Torch cut 8 Saw cut 9 Drilled holes 10 Other (specify) 11 None (open hole)

SCREEN-PERFORATED INTERVALS: From ft. to ft., From ft. to ft
From ft. to ft., From ft. to ft
GRAVEL PACK INTERVALS: From ft. to ft., From ft. to ft
From ft. to ft., From ft. to ft

GROUT MATERIAL: 1 Neat cement 2 Cement grout 3 Bentonite 4 Other Quick Kote
Grout Intervals: From 25 ft. to 20 ft., From 8 ft. to 3 Below Ground ft., From ft. to ft

What is the nearest source of possible contamination:
1 Septic tank 2 Sewer lines 20ft. 3 Watertight sewer lines 4 Lateral lines 5 Cess pool 6 Seepage pit 7 Pit privy 8 Sewage lagoon 9 Feedyard 10 Livestock pens 5 Rein 11 Fuel storage 12 Fertilizer storage 13 Insecticide storage 14 Abandoned water well 15 Oil well/Gas well 16 Other (specify below)
How many feet?
Direction from well? North

FROM	TO	LITHOLOGIC LOG	FROM	TO	PLUGGING INTERVALS
25'	20'				Concrete
8'	3'				Concrete
8'	3'	Compacted dirt.			
		5" Casing cut off 3 ft Below ground			

RECEIVED
JUL 0 2 2008
BUREAU OF WATER

CORRECTED

CONTRACTOR'S OR LANDOWNER'S CERTIFICATION: This water well was (1) constructed, (2) reconstructed, or (3) plugged under my jurisdiction and was completed on (mo/day/year) 6/30/07 and this record is true to the best of my knowledge and belief. Kansas Water Well Contractor's License No This Water Well Record was completed on (mo/day/yr) 7-1-08 under the business name of by (signature)

INSTRUCTIONS: Use typewriter or ball point pen. PLEASE PRESS FIRMLY and PRINT clearly. Please fill in blanks, underline or circle the correct answers. Send top three copies to Kansas Department of Health and Environment, Bureau of Water, Geology Section, 1000 SW Jackson St., Suite 420, Topeka, Kansas 66612-1367. Telephone 785-296-5522. Send one to WATER WELL OWNER and retain one for your records. Fee of $5.00 for each constructed well.