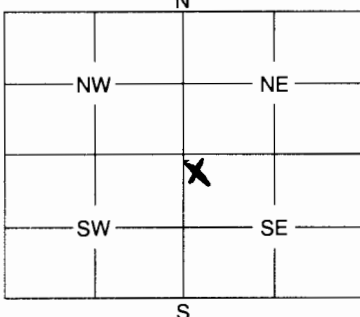


1	LOCATION OF WATER WELL: 119 N Arcadia	Fraction 1/4 1/4 1/4 1/4	Section Number 20	Township Number 27S	Range Number 1
---	---	------------------------------------	-----------------------------	-------------------------------	--------------------------

Distance and direction from nearest town or city street address of well if located within city?
119 N Arcadia

2	WATER WELL OWNER: Austin Brunley	
	RR #, St. Address, Box #: 534 S Floyd	Board of Agriculture, Division of Water Resources
	City, State, ZIP Code: Nichols, KS 67209	Application Number: 50

3	MARK WELL'S LOCATION WITH AN "X" IN SECTION BOX: 
4	DEPTH OF WELL 50 ft. WELL'S STATIC WATER LEVEL 27 ft. WELL WAS USED AS: ☒ 1 Domestic ☐ 2 Irrigation ☐ 3 Feedlot ☐ 4 Industrial ☐ 5 Public Water Supply ☐ 6 Oil Field Water Supply ☐ 7 Domestic (Lawn & Garden) ☐ 8 Air Conditioning ☐ 9 Dewatering ☐ 10 Monitoring Well ☐ 11 Injection Well ☐ 12 Other Was a chemical / bacteriological sample submitted to Department? Yes No ☒ X..... If yes, mo/day/yr sample was submitted Water Well Disinfected: Yes ☒ X No

5	TYPE OF BLANK CASING USED:	
	1 Steel 3 RMP (SR) 5 Wrought 7 Fiberglass 9 Other (Specify below) ☒ 2 PVC 4 ABS 6 Asbestos-Cement 8 Concrete Tile	
	Blank casing diameter 5 in. Was casing pulled? Yes No If yes, how much Casing height above or below land surface 12 in.	

6	GROUT PLUG MATERIAL: 1 Neat cement 2 Cement grout ☒ 3 Bentonite 4 Other	
	Grout Plug Intervals: From 3 ft. to 20 ft., From ft. to ft., From to ft.	
	What is the nearest source of possible contamination: ☒ 1 Septic tank ☐ 2 Sewer lines ☒ 3 Watertight sewer lines ☐ 4 Lateral lines ☐ 5 Cess pool ☐ 6 Seepage pit ☐ 7 Pit privy ☐ 8 Sewage lagoon ☐ 9 Feedyard ☐ 10 Livestock pens ☐ 11 Fuel storage ☐ 12 Fertilizer storage ☐ 13 Insecticide storage ☐ 14 Abandoned water well ☐ 15 Oil well/Gas well ☐ 16 Other (specify below) Direction from well? S How many feet? 50	

FROM	TO	PLUGGING MATERIALS
0	3	Top Soil
3	18	Clay
18	30	Fine Sand
30	50	Med Sand

7	CONTRACTOR'S OF LANDOWNER'S CERTIFICATION: This water well was plugged under my jurisdiction and was completed on (mo/day/year) 10/19/09 and this record is true to the best of my knowledge and belief. Kansas Water Well Contractor's License No. 238 This Water Well Record was completed on (mo/day/year) 10/19/09 under the business name of Premier Pump & Well Service, Inc. by (signature) Chelra K. Crucher	
---	--	--

INSTRUCTIONS: Use typewriter or ball point pen. Please press firmly and print clearly. Please fill in blanks, underline or circle the correct answers. Send top three copies to Kansas Department of Health and Environment, Bureau of Water, Geology Section, 1000 SW Jackson St., Ste. 420, Topeka, Kansas 66612-1367. Telephone: 785/296-5522. Send one to Water Well Owner and retain one for your records.