

WATER WELL PLUGGING RECORD Form WWC-5P


KSA 82a-1212

ID NO.

MW-5

1 LOCATION OF WATER WELL: County: SEDGWICK		Fraction NW ¼ NW ¼ NW ¼ NW ¼	Section Number 17	Township Number T 27 S	Range Number 1 ☐ E ☒ W
Street/Rural Address of Well Location; if unknown, distance & direction from nearest town or intersection: If at owner's address, check here ☐ 10315 W 13TH ST N, WICHITA, KS			Global Positioning Systems (GPS) information: Latitude: _____ (in decimal degrees) Longitude: _____ (in decimal degrees) Elevation: _____ Datum: ☐ WGS84, ☐ NAD83, ☐ NAD27 Collection Method: ☐ GPS unit (Make/Model: _____) ☐ Digital Map/Photo, ☐ Topographic Map, ☐ Land Survey Est. Accuracy: ☐ < 3 m, ☐ 3-5 m, ☐ 5-15 m, ☐ > 15 m		
2 WATER WELL OWNER: QUIK TRIP CORP. RR#, St. Address, Box #: PO BOX 3475 City, State ZIP Code: TULSA, OK 74101-3475					

3 MARK WELL'S LOCATION WITH AN "X" IN SECTION BOX:

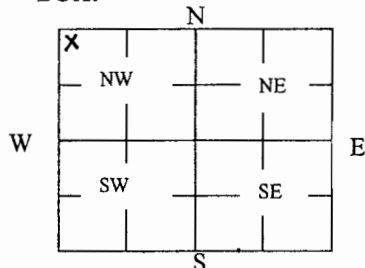

4 DEPTH OF WELL 31 ft.

WELL'S STATIC WATER LEVEL 25 ft

WELL WAS USED AS:

- | | | |
|-------------------------------------|---|--|
| ☐ Domestic | ☐ Public Water Supply | ☐ Dewatering |
| ☐ Irrigation | ☐ Oil Field Water Supply | ☒ Monitoring |
| ☐ Feedlot | ☐ Domestic (Lawn & Garden) | ☐ Injection Well |
| ☐ Industrial | ☐ Air Conditioning | ☐ Other _____ |

Was a chemical/bacteriological sample submitted to Department? Yes ☐ No ☒

5 TYPE OF BLANK CASING USED:

- ☐ Steel ☐ RMP (SR) ☐ Wrought ☐ Fiberglass ☐ Other (Specify below)
☒ PVC ☐ ABS ☐ Asbestos-Cement ☐ Concrete Tile

Blank casing diameter 2 in. Was casing pulled? Yes ☒ No ☐ If yes, how much 3 FT.
Casing height above or below land surface _____ in.

6 GROUT PLUG MATERIAL:

- ☐ Neat cement ☐ Cement grout ☐ Bentonite ☐ Other _____

Grout Plug Intervals: From 31 ft. to 0.5 ft., From _____ ft. to _____ ft., From _____ to _____ ft.

What is the nearest source of possible contamination:

- | | | | |
|---|---|--|--|
| ☐ Septic tank | ☐ Seepage pit | ☒ Fuel Storage | ☐ Other (specify below) |
| ☐ Sewer lines | ☐ Pit privy | ☐ Fertilizer storage | |
| ☐ Watertight sewer lines | ☐ Sewage lagoon | ☐ Insecticide storage | |
| ☐ Lateral lines | ☐ Feedyard | ☐ Abandoned water well | Direction from well? N |
| ☐ Cess pool | ☐ Livestock pens | ☐ Oil well/Gas well | How many feet? 15 |

FROM	TO	PLUGGING MATERIALS	FROM	TO	PLUGGING MATERIALS
31	0.5	BENTONITE CHIPS			

RECEIVED

DEC 21 2009

BUREAU OF WATER

7 CONTRACTOR'S OR LANDOWNER'S CERTIFICATION: This water well was plugged under my jurisdiction and was completed on (mo/day/year) 12/9/2009 and this record is true to the best of my knowledge and belief. Kansas Water Well Contractor's License No. 416. This Water Well Record was completed on (mo/day/year) 12/14/2009 under the business name of TERRACON CONSULTANTS, INC. by (signature) *BLS. Klu*

INSTRUCTIONS: Use typewriter or ballpoint pen. Please press firmly and print clearly. Please fill in blanks, underline or circle the correct answers. Send top three copies to Kansas Department of Health and Environment, Bureau of Water, Geology Section, 1000 SW Jackson St., Ste. 420, Topeka, Kansas 66612-1367. Telephone: 785/296-5524. Send one to Water Well Owner and retain one for your records. Visit us at <http://www.kdheks.gov/waterwell/index.html>.

Check one: ☐ White Copy ☒ Blue Copy ☐ Pink Copy