

CORRECTION(S) TO WATER WELL RECORD (WWC-5)

(to rectify lacking or incorrect information)

County:

Sedgwick

Location listed as:

Section-Township-Range: None Given

Fraction ($\frac{1}{4}$ $\frac{1}{4}$ $\frac{1}{4}$): _____

Location changed to:

25-27S-1W

NE NW NW

Other changes: Initial statements: _____

Changed to: _____

Comments: _____

verification method: wellsite address, city street map, and
mapping tool on KGS website.

initials: DRK date: 4/26/2011

submitted by: Kansas Geological Survey, Data Resources Library, 1930 Constant Ave., Lawrence, KS 66047-3726

to: Kansas Dept of Health & Environment, Bureau of Water, 1000 SW Jackson, Suite 420, Topeka, KS 66612-1367.

WATER WELL PLUGGING RECORD Form WWC-5P

KSA 82a-1212

ID NO.

1 LOCATION OF WATER WELL: Fraction $\frac{1}{4}$ $\frac{1}{4}$ $\frac{1}{4}$ Section Number Township Number Range Number E/W

Distance and direction from nearest town or city street address of well if located within city?

Same as Below

2 WATER WELL OWNER: Francisco Carrillo Jr.

RR#, St. Address, Box #: 345 S Kessler

City, State ZIP Code: Wichita KS 67213

Global Positioning Systems (decimal degrees, min. of 4 digits)

Latitude: _____


Longitude: _____

Elevation: _____

Datum: _____

Data Collection Method: _____

3 MARK WELL'S LOCATION WITH AN "X" IN SECTION BOX:

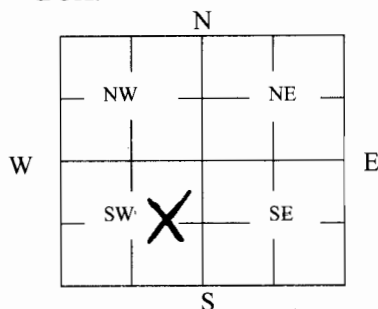

4 DEPTH OF WELL 24 ft.

WELL'S STATIC WATER LEVEL 17 ft

WELL WAS USED AS:

☒ Domestic

☐ Irrigation

☐ Feedlot

☐ Industrial

☐ Public Water Supply

☐ Oil Field Water Supply

☐ Domestic (Lawn & Garden)

☐ Air Conditioning

☐ Dewatering

☐ Monitoring

☐ Injection Well

☐ Other _____

Was a chemical/bacteriological sample submitted to Department? Yes _____ No ☒

5 TYPE OF BLANK CASING USED:

☒ Steel

☐ RMP (SR)

☐ Wrought

☐ Fiberglass

☐ Other (Specify below) _____

☐ PVC

☐ ABS

☐ Asbestos-Cement

☐ Concrete Tile

Blank casing diameter 2 in. Was casing pulled? Yes _____ No ☒ If yes, how much _____

Casing height above or below land surface 36 in.

6 GROUT PLUG MATERIAL: 1 Neat cement ☒ Cement grout 3 Bentonite 4 Other _____

Grout Plug Intervals: From _____ ft. to _____ ft., From _____ ft. to _____ ft., From _____ to _____ ft.

What is the nearest source of possible contamination:

☐ Septic tank

☐ Seepage pit

☐ Fuel Storage

☐ Other (specify below) _____

☒ Sewer lines

☐ Pit privy

☐ Fertilizer storage

☐ Watertight sewer lines

☐ Sewage lagoon

☐ Insecticide storage

☐ Lateral lines

☒ Feedyard

☐ Abandoned water well

Direction from well? North

☐ Cess pool

☒ Livestock pens

☐ Oil well/Gas well

How many feet? 15'

FROM	TO	PLUGGING MATERIALS	FROM	TO	PLUGGING MATERIALS
24'	3'	Sand & Portland Cement			
3'	0'	Fill dirt / topsoil			

7 CONTRACTOR'S OR LANDOWNER'S CERTIFICATION: This water well was plugged under my jurisdiction and was completed on (mo/day/year) 1-28-11 and this record is true to the best of my knowledge and belief. Kansas Water Well Contractor's License No. N/A Home. This Water Well Record was completed on (mo/day/year) _____ under the business name of Owner by (signature) _____

INSTRUCTIONS: Use typewriter or ballpoint pen. Please press firmly and print clearly. Please fill in blanks, underline or circle the correct answers. Send top three copies to Kansas Department of Health and Environment, Bureau of Water, Geology Section, 1000 SW Jackson St., Ste. 420, Topeka, Kansas 66612-1367. Telephone: 785/296-5522. Send one to Water Well Owner and retain one for your records. Visit us at <http://www.kdheks.gov/geo/waterwells>.