

WATER WELL PLUGGING RECORD Form WWC-5P
KSA 82a-1212
ID NO.
EMW-4

1 LOCATION OF WATER WELL: Sedgwick County	Fraction NW ¼ NE ¼ SE ¼	Section Number 27	Township Number 27 S	Range Number R 1 W
---	----------------------------	----------------------	-------------------------	-----------------------

Distance and direction from nearest town or city street address of well if located within city?

Well was located at 6001-6401 W. Kellogg, Wichita, KS

2 WATER WELL OWNER: Johnson's General Store #18/Payless Car Rental RR#, St. Address, Box #: 6001-6401 W. Kellogg City, State ZIP Code: Wichita, KS 67209	Global Positioning Systems (decimal degrees, min. of 4 digits) Latitude: _____ Longitude: _____ Elevation: _____ Datum: _____ Data Collection Method: _____
--	---

3 MARK WELL'S LOCATION WITH AN "X" IN SECTION BOX:

N

NW	NE
SW	SE

S

WE

4 DEPTH OF WELL 17.01 ft.

WELL'S STATIC WATER LEVEL 14.14 ft

WELL WAS USED AS: X

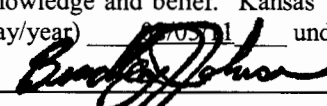
1 Domestic	5 Public Water Supply	9 Dewatering
2 Irrigation	6 Oil Field Water Supply	10 Monitoring
3 Feedlot	7 Domestic (Lawn & Garden)	11 Injection Well
4 Industrial	8 Air Conditioning	12 Other _____

Was a chemical/bacteriological sample submitted to Department? Yes _____ No x _____

5 TYPE OF BLANK CASING USED:			
1 Steel	3 RMP (SR)	5 Wrought	7 Fiberglass
2 PVC	4 ABS	6 Asbestos-Cement	8 Concrete Tile
9 Other (Specify below) _____			
Blank casing diameter <u>2</u> in. Was casing pulled? Yes <u>x</u> No _____ If yes, how much <u>3'</u>			
Casing height above or below land surface _____ in.			

6 GROUT PLUG MATERIAL:	1 Neat cement	2 Cement grout	3 Bentonite	4 Other <u>Soil</u>
Grout Plug Intervals: From <u>2</u> <u>0</u> ft. to <u>0.5</u> ft., From <u>3</u> <u>0.5</u> ft. to <u>14.14</u> ft., From _____ to _____ ft.				
What is the nearest source of possible contamination:				
1 Septic tank	6 Seepage pit	11 Fuel Storage	16 Other (specify below)	
2 Sewer lines	7 Pit privy	12 Fertilizer storage	_____ Contaminated Site _____	
3 Watertight sewer lines	8 Sewage lagoon	13 Insecticide storage	Direction from well? _____	
4 Lateral lines	9 Feedyard	14 Abandoned water well	How many feet? _____	
5 Cess pool	10 Livestock pens	15 Oil well/Gas well		

FROM	TO	PLUGGING MATERIALS	FROM	TO	PLUGGING MATERIALS
0'	0.5'	Concrete			
0.5'	14.14'	Bentonite Chips			

7 CONTRACTOR'S OR LANDOWNER'S CERTIFICATION: This water well was plugged under my jurisdiction and was completed on (mo/day/year) 07/11/11 and this record is true to the best of my knowledge and belief. Kansas Water Well Contractor's License No. 585. This Water Well Record was completed on (mo/day/year) 07/05/11 under the business name of Associated Environmental, Inc. by (signature) 

INSTRUCTIONS: Use typewriter or ballpoint pen. Please press firmly and print clearly: Please fill in blanks, underline or circle the correct answers. Send top three copies to Kansas Department of Health and Environment, Bureau of Water, Geology Section, 1000 SW Jackson St., Ste. 420, Topeka, Kansas 66612-1367. Telephone: 785/296-5522. Send one to Water Well Owner and retain one for your records. Visit us at <http://www.kdheks.gov/waterwell/index.html>.