

WATER WELL PLUGGING RECORD Form WWC-5P

KSA 82a-1212

ID NO.

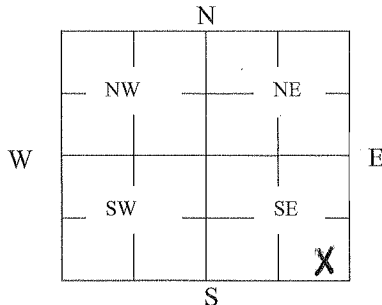
1 LOCATION OF WATER WELL: County: <u>Sedgwick</u>	Fraction <u>NW</u> $\frac{1}{4}$ $\frac{1}{4}$	Section Number <u>25</u>	Township Number <u>27S</u>	Range Number <u>1E</u>
--	---	-----------------------------	-------------------------------	---------------------------

Distance and direction from nearest town or city street address of well if located within city?

Wichita3323 W Maple

2 WATER WELL OWNER: <u>Roy Busch</u> RR#, St. Address, Box #: <u>9835 Par</u> City, State ZIP Code: <u>Wichita, KS 67212</u>	Global Positioning Systems (decimal degrees, min. of 4 digits) Latitude: _____ Longitude: _____ Elevation: _____ Datum: _____ Data Collection Method: _____
--	--

3 MARK WELL'S LOCATION WITH AN "X" IN SECTION BOX:

4 DEPTH OF WELL 28 ft.WELL'S STATIC WATER LEVEL 16 ft

WELL WAS USED AS:

☒ 1 Domestic☐ 2 Irrigation☐ 3 Feedlot☒ 4 Industrial☐ 5 Public Water Supply☐ 6 Oil Field Water Supply☐ 7 Domestic (Lawn & Garden)☐ 8 Air Conditioning☐ 9 Dewatering☐ 10 Monitoring☐ 11 Injection Well☐ 12 Other _____

Was a chemical/bacteriological sample submitted to Department? Yes _____ No _____

5 TYPE OF BLANK CASING USED:

☐ 1 Steel☐ 3 RMP (SR)☐ 5 Wrought☐ 7 Fiberglass☐ 9 Other (Specify below) _____☒ 2 PVC☐ 4 ABS☐ 6 Asbestos-Cement☐ 8 Concrete TileBlank casing diameter 6 in. Was casing pulled? Yes _____ No ☒ If yes, how much _____Casing height above or below land surface 42 in.6 GROUT PLUG MATERIAL: 1 Neat cement ☒ 2 Cement grout 3 Bentonite 4 Other _____Grout Plug Intervals: From 3 ft. to 0 ft., From _____ ft. to _____ ft., From _____ to _____ ft.

What is the nearest source of possible contamination:

☐ 1 Septic tank☐ 6 Seepage pit☐ 11 Fuel Storage☐ 16 Other (specify below) _____☐ 2 Sewer lines☐ 7 Pit privy☐ 12 Fertilizer storage☒ 3 Watertight sewer lines☐ 8 Sewage lagoon☐ 13 Insecticide storage☐ 4 Lateral lines☐ 9 Feedyard☐ 14 Abandoned water wellDirection from well? East☐ 5 Cess pool☐ 10 Livestock pens☐ 15 Oil well/Gas wellHow many feet? 3

FROM	TO	PLUGGING MATERIALS	FROM	TO	PLUGGING MATERIALS
<u>28"</u>	<u>3"</u>	<u>Sand</u>			
<u>3"</u>	<u>0'</u>	<u>Cement Grout</u>			

7 CONTRACTOR'S OR LANDOWNER'S CERTIFICATION: This water well was plugged under my jurisdiction and was completed on (mo/day/year) November 21, 2011 and this record is true to the best of my knowledge and belief. Kansas Water Well Contractor's License No. _____. This Water Well Record was completed on (mo/day/year) 11-21-2011 under the business name of _____ by (signature) Roy Busch

INSTRUCTIONS: Use typewriter or ballpoint pen. Please press firmly and print clearly. Please fill in blanks, underline or circle the correct answers. Send top three copies to Kansas Department of Health and Environment, Bureau of Water, Geology Section, 1000 SW Jackson St., Ste. 420, Topeka, Kansas 66612-1367. Telephone: 785/296-5522. Send one to Water Well Owner and retain one for your records. Visit us at <http://www.kdheks.gov/geo/waterwells>.