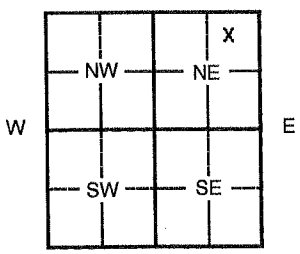


1 LOCATION OF WATER WELL: County: Sedgwick	Fraction NW 1/4 NE 1/4 NE 1/4	Section Number 31	Township Number 27S	Range Number 1 W
Distance and direction from nearest town or city street address of well if located within city? 10723 W. Kellogg Dr. - Wichita				


2 WATER WELL OWNER: El Paso Merchant Energy-Petroleum Co. RR#, St. Address, Box #: 2 N. Nevada City, State, ZIP Code: Colorado Springs, CO 80903	Global Positioning System (decimal degrees, min. of 4 digits) Latitude: _____ Longitude: _____ Elevation: _____ Datum: _____ Data Collection Method: _____
---	--

3 MARK WELL'S LOCATION WITH AN "X" IN SECTION BOX: N  S	4 DEPTH OF WELL <u>37.65</u> ft. WELL'S STATIC WATER LEVEL <u>27.09</u> ft. WELL WAS USED AS: <table border="0"> <tr> <td>1 Domestic</td> <td>5 Public Water Supply</td> <td>9 Dewatering</td> </tr> <tr> <td>2 Irrigation</td> <td>6 Oil Field Water Supply</td> <td>10 Monitoring</td> </tr> <tr> <td>3 Feedlot</td> <td>7 Domestic (Lawn & Garden)</td> <td>11 Injection Well</td> </tr> <tr> <td>4 Industrial</td> <td>8 Air Conditioning</td> <td>12 Other Air Sparge</td> </tr> </table> Was a chemical/bacteriological sample submitted to Department? Yes ___ No X	1 Domestic	5 Public Water Supply	9 Dewatering	2 Irrigation	6 Oil Field Water Supply	10 Monitoring	3 Feedlot	7 Domestic (Lawn & Garden)	11 Injection Well	4 Industrial	8 Air Conditioning	12 Other Air Sparge
1 Domestic	5 Public Water Supply	9 Dewatering											
2 Irrigation	6 Oil Field Water Supply	10 Monitoring											
3 Feedlot	7 Domestic (Lawn & Garden)	11 Injection Well											
4 Industrial	8 Air Conditioning	12 Other Air Sparge											

5 TYPE OF BLANK CASING USED:				
1 Steel	3 RMP (SR)	5 Wrought	7 Fiberglass	9 Other (Specify below)
2 PVC	4 ABS	6 Asbestos-Cement	8 Concrete Tile	
Blank casing diameter <u>2</u> in. Was casing pulled? Yes ___ No X If yes, how much _____ Casing height above or <u>below</u> land surface <u>48</u> in. (overdrilled from 0 to 4 feet bgs)				

6 GROUT PLUG MATERIAL:	1 Neat cement	2 Cement grout	3 Bentonite	4 Other _____
Grout Plug Intervals: From <u>1</u> ft. to <u>37.65</u> ft., From _____ ft. to _____ ft., From _____ to _____ ft.				
What is the nearest source of possible contamination:				
1 Septic tank	6 Seepage pit	11 Fuel Storage	16 Other (specify below)	
2 Sewer lines	7 Pit privy	12 Fertilizer storage		
3 Watertight sewer lines	8 Sewage lagoon	13 Insecticide storage		
4 Lateral lines	9 Feedyard	14 Abandoned water well	Direction from well?	
5 Cess pool	10 Livestock pens	15 Oil well/Gas well	How many feet?	

FROM	TO	PLUGGING MATERIALS	FROM	TO	PLUGGING MATERIALS
0	1	Native Soil			
1	37.65	Bentonite Chips			

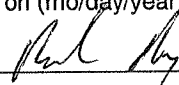7 CONTRACTOR'S OR LANDOWNER'S CERTIFICATION: This water well was plugged under my jurisdiction and was completed on (mo/day/year) 02/08/12 and this record is true to the best of my knowledge and belief. Kansas Water Well Contractor's License No. 531. This Water Well Record was completed on (mo/day/year) 02/10/12 under the business name of Geotechnical Services, Inc. by (signature) .

INSTRUCTIONS: Please fill in blanks or circle the correct answers. Send top three copies to Kansas Department of Health and Environment, Bureau of Water, Geology Section, 1000 SW Jackson St., Ste. 420, Topeka, Kansas 66612-1367. Telephone: 785/296-5522. Send one to Water Well Owner and retain one for your records. Visit us at <http://www.kdheks.gov/waterwell>.