

SE NW NE NW

WATER WELL PLUGGING RECORD Form WWC-5P

KSA 82a-1212 ID NO.

1 LOCATION OF WATER WELL: County: Saline Fraction NE 1/4 NE 1/4 NW 1/4 Section Number 12 Township Number 27 Range Number 1 E/W W

Distance and direction from nearest town or city street address of well if located within city?

2052 n Now2 WATER WELL OWNER: Mr FullertonRR#, St. Address, Box #: 2052 n NowCity, State ZIP Code: Wichita KS 67203

Global Positioning Systems (decimal degrees, min. of 4 digits)

Latitude: _____

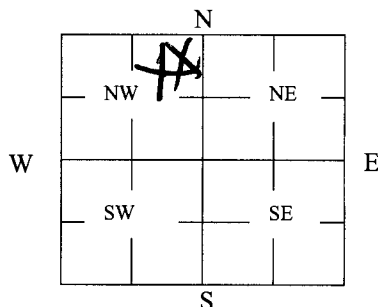
Longitude: _____

Elevation: _____

Datum: _____

Data Collection Method: _____

3 MARK WELL'S LOCATION WITH AN "X" IN SECTION BOX:

4 DEPTH OF WELL 35 ft.WELL'S STATIC WATER LEVEL 13 ft

WELL WAS USED AS:

1 Domestic

2 Irrigation

3 Feedlot

4 Industrial

5 Public Water Supply

6 Oil Field Water Supply

7 Domestic (Lawn & Garden)

8 Air Conditioning

9 Dewatering

10 Monitoring

11 Injection Well

12 Other _____

Was a chemical/bacteriological sample submitted to Department? Yes _____ No X

5 TYPE OF BLANK CASING USED:

1 Steel

2 RMP (SR)

3 Wrought

4 Fiberglass

5 Other (Specify below)

6 PVC

7 ABS

8 Asbestos-Cement

9 Concrete Tile

Blank casing diameter 6 in. Was casing pulled? Yes _____ No X If yes, how much 6" Below Basement FloorCasing height above or below land surface 6 in.

6 GROUT PLUG MATERIAL: 1 Neat cement 2 Cement grout 3 Bentonite 4 Other _____

Grout Plug Intervals: From 13 ft. to 0 ft., From _____ ft. to _____ ft., From _____ to _____ ft.

What is the nearest source of possible contamination:

1 Septic tank

2 Seepage pit

3 Fuel Storage

4 Other (specify below)

5 Sewer lines

6 Pit privy

7 Fertilizer storage

8 Watertight sewer lines

9 Sewage lagoon

10 Insecticide storage

11 Lateral lines

12 Feedyard

13 Abandoned water well

Direction from well? north

12 Cess pool

13 Livestock pens

14 Oil well/Gas well

How many feet? 10

FROM	TO	PLUGGING MATERIALS	FROM	TO	PLUGGING MATERIALS
<u>35</u>	<u>13</u>	<u>Sand & gravel</u>			
<u>13</u>	<u>0</u>	<u>Cement grout</u>			

7 CONTRACTOR'S OR LANDOWNER'S CERTIFICATION: This water well was plugged under my jurisdiction and was completed on (mo/day/year) 12-11-12 and this record is true to the best of my knowledge and belief. Kansas Water Well Contractor's License No. 472. This Water Well Record was completed on (mo/day/year) 12-11-12 under the business name of David Bahr by (signature) Barclay Pump & Well

INSTRUCTIONS: Use typewriter or ballpoint pen. Please press firmly and print clearly. Please fill in blanks, underline or circle the correct answers. Send top three copies to Kansas Department of Health and Environment, Bureau of Water, Geology Section, 1000 SW Jackson St., Ste. 420, Topeka, Kansas 66612-1367. Telephone: 785/296-5522. Send one to Water Well Owner and retain one for your records. Visit us at <http://www.kdheks.gov/geo/waterwells>.