

WATER WELL PLUGGING RECORD

Form WWC-5P

KSA 82a-1212

ID NO.

1 LOCATION OF WATER WELL: Fraction NE 1/4 NE 1/4 NE 1/4 Section Number 1 Township Number T 27 S Range Number 1 ☐ E ☒ W

Street/Rural Address of Well Location; if unknown, distance & direction from nearest town or intersection: If at owner's address, check here ☐

Global Positioning Systems (GPS) information:

Latitude: _____ (in decimal degrees)

Longitude: _____ (in decimal degrees)

Elevation: _____

Datum: ☐ WGS84, ☐ NAD83, ☐ NAD27

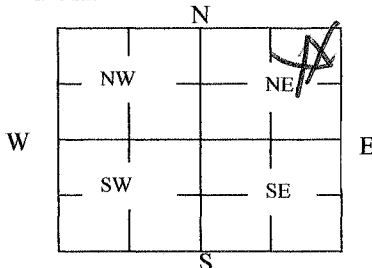
Collection Method: _____

2 WATER WELL OWNER:

RR#, St. Address, Box #: Remax 2201 W 29th
City, State ZIP Code: White Ks 67204

☐ GPS unit (Make/Model): _____☐ Digital Map/Photo, ☐ Topographic Map, ☐ Land SurveyEst. Accuracy: ☐ <3 m, ☐ 3-5 m, ☐ 5-15 m, ☐ >15 m

3 MARK WELL'S LOCATION WITH AN "X" IN SECTION BOX:

4 DEPTH OF WELL 25 ft.WELL'S STATIC WATER LEVEL 11 ft

WELL WAS USED AS:

☐
☐
☐
☐

Domestic
Irrigation
Feedlot
Industrial

☐
☐
☒
☐

Public Water Supply
Oil Field Water Supply
Domestic (Lawn & Garden)
Air Conditioning

☐
☐
☐
☐

Dewatering
Monitoring
Injection Well
Other _____

Was a chemical/bacteriological sample submitted to Department? Yes ☐ No ☒

5 TYPE OF BLANK CASING USED:

☒
☐

Steel
PVC

☐
☐

RMP (SR)
ABS

☐
☐

Wrought
Asbestos-Cement

☐
☐

Fiberglass
Concrete Tile

☐ Other (Specify below) _____Blank casing diameter 1 1/4 in. Was casing pulled? Yes ☒ No ☐ If yes, how much 5'Casing height above or below land surface 60 in.6 GROUT PLUG MATERIAL: ☐ Neat cement ☒ Cement grout ☐ Bentonite ☐ Other _____Grout Plug Intervals: From 25 ft. to 0 ft., From _____ ft. to _____ ft., From _____ ft. to _____ ft.

What is the nearest source of possible contamination:

☐
☐
☒
☐
☐

Septic tank
Sewer lines
Watertight sewer lines
Lateral lines
Cess pool

☐
☐
☐
☐
☐

Seepage pit
Pit privy
Sewage lagoon
Feedyard
Livestock pens

☐
☐
☐
☐
☐

Fuel storage
Fertilizer storage
Insecticide storage
Abandoned water well
Oil well/Gas well

☐ Other (specify below) _____Direction from well? South
How many feet? 4'

FROM	TO	PLUGGING MATERIALS	FROM	TO	PLUGGING MATERIALS
<u>25</u>	<u>0</u>	<u>Cement grout</u>			

7 CONTRACTOR'S OR LANDOWNER'S CERTIFICATION: This water well was plugged under my jurisdiction and was completed on (mo/day/year) 10-8-13 and this record is true to the best of my knowledge and belief. Kansas Water Well Contractor's License No. 472. This Water Well Record was completed on (mo/day/year) 10-8-13 under the business name of Beardon Pump & Well by (signature) David Beck

INSTRUCTIONS: Use typewriter or ballpoint pen. Please press firmly and print clearly. Please fill in blanks, underline or circle the correct answers. Send top three copies to Kansas Department of Health and Environment, Bureau of Water, Geology Section, 1000 SW Jackson St., Ste. 420, Topeka, Kansas 66612-1367. Telephone: 785/296-5524. Send one to Water Well Owner and retain one for your records. Visit us at <http://www.kdheks.gov/waterwell/index.html>.