WATER WELL RECORD Form WWC-5 KSA 82a-1212

1 LOCATION OF WATER WELL:	FRACTION	SECTION NUMBER	TOWNSHIP NUMBER	RANGE NUMBER
Sedgwick	NW 1/4 NE 1/4 NW 1/4	3	T 27 S	R 1W E/W

Distance and direction from nearest town or city street address of well if located within city?
3/8 mile East of Ridge Road, South side of 29th N. Wichita, Kansas (2 logs on 1 permit)

2 WATER WELL OWNER: WICHITA, CITY OF
RR#,ST. ADDRESS,BOX #: 455 N. Main
CITY, STATE: Wichita, Kansas ZIP CODE: 67202
Board of Agriculture, Division of Water Resource
Application Number: 20140291

3 LOCATE WELL'S LOCATION WITH AN "X" IN SECTION BOX:

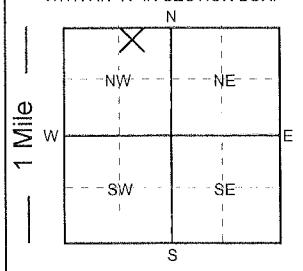

4 DEPTH OF COMPLETED WELL: 40 ft. ELEVATION:
Depth of groundwater Encountered: ft. ft. ft.
WELL'S STATIC WATER LEVEL 10 FT. BELOW LAND SURFACE MEASURED ON mo/day/yr: 4/7/14
Pump test data: Well water was ft. after hours of pumping @ gpm
Est. Yield: gpm Well water was ft. after hours of pumping @ gpm
Bore Hole Diameter 12 in. to 40 ft. and in. to ft.
WELL WATER TO BE USED AS: 1. Domestic 2. Irrigation 3. Feedlot 4. Industrial 5. Public water supply 6. Oil field water supply 7. Lawn and garden only 8. Air conditioning 9. Dewatering 10. Monitoring well 11. Injection well 12. Other (Specify below)
Was a chemical/bacteriological sample submitted to Department? YES (NO) ; If yes, what mo/day/yr was sample submitted
Was Water Well Disinfected? (YES) NO

5 TYPE OF CASING USED: 1. Steel 2. PVC 3. RPM (SR) 4. ABS 5. Wrought Iron 6. Asbestos-Cement 7. Fiberglass 8. Concrete tile 9. Other (Specify below)
CASING JOINTS: (Glued) Welded Threaded Clamped
Blank casing diameter 8 in. to 20 ft., Dia. in. to ft., Dia. in. to ft.
Casing height above land surface: 12 in., Weight: 5.52 lbs. / ft. Wall thickness or gauge No. .332

TYPE OF SCREEN OR PERFORATION MATERIAL:
1. Steel 2. Brass 3. Stainless Steel 4. Galvanized 5. Fiberglass 6. Concrete Tile (7. PVC) 8. RMP (SR) 9. ABS 10. Asbestos-Cement 11. Other (specify) 12. None used (open hole)

SCREEN OR PERFORATION OPENINGS ARE:
1. Continuous slot 2. Louvered shutter 3. Mill slot 4. Key punched 5. Gauzed wrapped 6. Wire wrapped (8. Saw cut) 9. Drilled holes 10. Other (specify) 11. None (open hole)

SCREEN - PERFORATION INTERVAL From 20 ft. to 30 ft., From ft. to ft.
From ft. to ft., From ft. to ft.
GRAVEL PACK INTERVALS: From 20 ft. to 40 ft., From ft. to ft.
From ft. to ft., From ft. to ft.

6 GROUT MATERIALS: 1. Neat cement 2. Cement Grout 3. Bentonite Other bentonite hole plug
Grout Intervals: From 0 ft. to 20 ft., From ft. to ft., From ft. to ft.
What is the nearest source of possible contamination:
1. Septic tank 2. Sewer lines 3. Watertight sewer line 4. Lateral lines 5. Cess Pool 6. Seepage pit 7. Pit privy 8. Sewage lagoon 9. Feed yard 10. Livestock pens 11. Fuel storage 12. Fertilizer storage 13. Insecticide storage 14. Abandon water well 15. Oil well/Gas well 16. Other (specify below) None Apparent
Direction from well? How many feet?

From	To	LITHOLOGIC LOG	From	To	LITHOLOGIC LOG
0	3	sandy topsoil			
3	24	fine sand			
24	40	medium sand			

7 Contractor's or Landowner's Certification: This water well was 1. (constructed) 2. reconstructed or 3. plugged under my jurisdiction and was completed on (mo/day/year) 4/7/2014 and this record is true to the best of my knowledge and belief.
Kansas Water Well Contractor's License No. 236 This water well record was completed on (mo/day/year) 4/10/2014
under the business name of Harp Well and Pump Service by (signature) Todd S. Harp