

WATER WELL RECORD


Form WWC-5

Division of Water Resources App. No.

1 LOCATION OF WATER WELL: County: Sedgwick, Fraction 1/4 1/4 NE 1/4 NE 1/4, Section Number 5, Township No. T 27 S, Range Number R 1 []E [x]W

Street/Rural Address of Well Location; if unknown, distance & direction from nearest town or intersection: If at owner's address, check here [x]. Global Positioning System (GPS) information: Latitude: ... Longitude: ... Elevation: ... Datum: [] WGS 84, [] NAD 83, [] NAD 27

2 WATER WELL OWNER: Andrea Taylor-Craft, RR#, Street Address, Box #: 9129 W. Ryan Ct., City, State, ZIP Code : Wichita, KS 67205. Collection Method: [] GPS unit, [] Digital Map/Photo, [] Topographic Map, [] Land Survey. Est. Accuracy: [] <3 m, [] 3-5 m, [] 5-15 m, [] >15 m

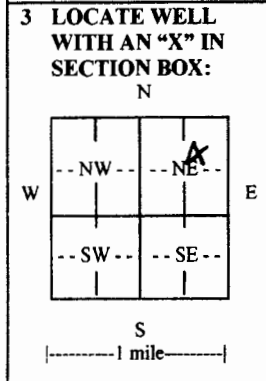

3 LOCATE WELL WITH AN 'X' IN SECTION BOX: ... 4 DEPTH OF COMPLETED WELL 70 ft. Depth(s) Groundwater Encountered (1) 20 ft. (2) ... ft. (3) ... ft. WELL'S STATIC WATER LEVEL 20 ft. below land surface measured on mo/day/yr. Pump test data: Well water was ... ft. after ... hours pumping ... gpm. EST. YIELD 18 gpm. Well water was ... ft. after ... hours pumping ... gpm. Bore Hole Diameter 10 in. to 70 ft. and ... in. to ... ft. WELL WATER TO BE USED AS: [] Public water supply, [] Geothermal, [] Injection well, [] Domestic, [] Feedlot, [] Oil field water supply, [] Dewatering, [] Other (Specify below), [] Irrigation, [] Industrial, [x] Domestic-lawn & garden, [] Monitoring well. Was a chemical/bacteriological sample submitted to Department? [] Yes [x] No. If yes, mo/day/yr sample was submitted: ... Water well disinfected? [x] Yes [] No

5 TYPE OF CASING USED: [] Steel [x] PVC [] Other. CASING JOINTS: [x] Glued [] Clamped [] Welded [] Threaded. Casing diameter 5 in. to 70 ft., Diameter ... in. to ... ft., Diameter ... in. to ... ft. Casing height above land surface 12 in., Weight 2.5 lbs./ft., Wall thickness or gauge No. SDR26. TYPE OF SCREEN OR PERFORATION MATERIAL: [] Steel, [] Stainless Steel, [x] PVC, [] Other (Specify). [] Brass, [] Galvanized Steel, [] None used (open hole). SCREEN OR PERFORATION OPENINGS ARE: [] Continuous slot, [] Mill slot, [] Gauze wrapped, [] Torch cut, [] Drilled holes, [] None (open hole), [] Louvered shutter, [] Key punched, [] Wire wrapped, [x] Saw cut, [] Other (specify). SCREEN-PERFORATED INTERVALS: From 50' ft. to 70' ft., From ... ft. to ... ft., From ... ft. to ... ft. GRAVEL PACK INTERVALS: From 20' ft. to 70' ft., From ... ft. to ... ft., From ... ft. to ... ft.

6 GROUT MATERIAL: [] Neat cement, [] Cement grout, [x] Bentonite, [] Other. Grout Intervals: From 3 ft. to 20 ft., From ... ft. to ... ft., From ... ft. to ... ft. What is the nearest source of possible contamination: [] Septic tank, [x] Sewer lines, [] Watertight sewer lines, [] Lateral lines, [] Cesspool, [] Seepage pit, [] Pit privy, [] Sewage lagoon, [] Feedyard, [] Livestock pens, [] Fuel storage, [] Fertilizer storage, [] Insecticide storage, [] Abandoned water well, [] Oil well/gas well, [] Other (specify below). Direction from well west, Distance from well 75'

Table with columns: FROM, TO, LITHOLOGIC LOG, FROM, TO, LITHO. LOG (cont.) or PLUGGING INTERVALS. Rows: 0-3 Topsoil, 3-15 Clay, 15-40 Medium Sand, 40-50 Clay, 50-70 Medium Sand.

7 CONTRACTOR'S OR LANDOWNER'S CERTIFICATION: This water well was [x] constructed, [] reconstructed, or [] plugged under my jurisdiction and was completed on (mo/day/year) 04/15/2014 and this record is true to the best of my knowledge and belief. Kansas Water Well Contractor's License No. 238. This Water Well Record was completed on (mo/day/year) 04/17/2014 under the business name of Premier Pump & Well Service, Inc. by (signature) Marsela Hilgen

INSTRUCTIONS: Use typewriter or ball point pen. PLEASE PRESS FIRMLY and PRINT clearly. Please fill in blanks and check the correct answers. Send one copy to Kansas Department of Health and Environment, Bureau of Water, Geology Section, 1000 SW Jackson St., Suite 420, Topeka, Kansas 66612-1367. Telephone 785-296-5524. Send one copy to WATER WELL OWNER and retain one for your records. Include fee of \$5.00 for each constructed well. Visit us at