

WATER WELL RECORD

Form WWC-5


Division of Water Resources App. No.

1 LOCATION OF WATER WELL: County: Sedgwick	Fraction NW ¼ NW ¼ NW ¼ NW ¼	Section Number 15	Township No. T 27 S	Range Number R 1 <input type="checkbox"/> E <input checked="" type="checkbox"/> W
---	--	-----------------------------	-------------------------------	---

Street/Rural Address of Well Location; if unknown, distance & direction from nearest town or intersection: If at owner's address, check here .
**Phillips 66 on 13th
7115 West 13th Street, Wichita, KS 67212**

Global Positioning System (GPS) information:
Latitude: **37.42' 29.99"** (in decimal degrees)
Longitude: **97.25' 33.11"** (in decimal degrees)
Elevation: **1343**
Datum: WGS 84, NAD 83, NAD 27
Collection Method:
 GPS unit (Make/Model:)
 Digital Map/Photo, Topographic Map, Land Survey
Est. Accuracy: <3 m, 3-5 m, 5-15 m, >15 m

2 WATER WELL OWNER: **Kashif Khan**
RR#, Street Address, Box #: **7115 West 13th Street**
City, State, ZIP Code : **Wichita, KS 67212**

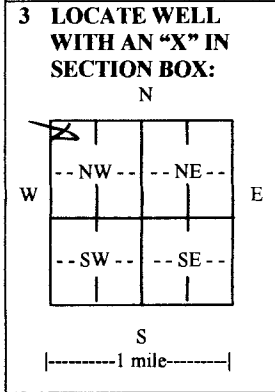

4 DEPTH OF COMPLETED WELL **31** ft.

Depth(s) Groundwater Encountered (1) **25** ft. (2) **N/A** ft. (3) **N/A** ft.
WELL'S STATIC WATER LEVEL **25.45** ft. below land surface measured on mo/day/yr. **3/7/2014**

Pump test data: Well water was **N/A** ft. after **N/A** hours pumping **N/A** gpm
EST. YIELD **N/A** gpm. Well water was **N/A** ft. after **N/A** hours pumping **N/A** gpm
Bore Hole Diameter **8.25** in. to **31** ft., and **N/A** in. to **N/A** ft.

WELL WATER TO BE USED AS: Public water supply Geothermal Injection well
 Domestic Feedlot Oil field water supply Dewatering Other (Specify below)
 Irrigation Industrial Domestic-lawn & garden Monitoring well **MW-2**

Was a chemical/bacteriological sample submitted to Department? Yes No
If yes, mo/day/yr sample was submitted. **N/A**

Water well disinfected? Yes No

5 TYPE OF CASING USED: Steel PVC Other

CASING JOINTS: Glued Clamped Welded Threaded
Casing diameter **2** in. to **16** ft., Diameter **N/A** in. to **N/A** ft., Diameter **N/A** in. to **N/A** ft.
Casing height above land surface **0** in., Weight **N/A** lbs./ft., Wall thickness or gauge No. **Schedule 40**

TYPE OF SCREEN OR PERFORATION MATERIAL:
 Steel Stainless Steel PVC Other (Specify)
 Brass Galvanized Steel None used (open hole)

SCREEN OR PERFORATION OPENINGS ARE:
 Continuous slot Mill slot Gauze wrapped Torch cut Drilled holes None (open hole)
 Louvered shutter Key punched Wire wrapped Saw cut Other (specify)

SCREEN-PERFORATED INTERVALS: From **16** ft. to **31** ft., From **N/A** ft. to **N/A** ft., From **N/A** ft. to **N/A** ft., From **N/A** ft. to **N/A** ft.
GRAVEL PACK INTERVALS: From **14** ft. to **31** ft., From **N/A** ft. to **N/A** ft., From **N/A** ft. to **N/A** ft., From **N/A** ft. to **N/A** ft.

6 GROUT MATERIAL: Neat cement Cement grout Bentonite Other **Concrete 0 to 2-feet**

Grout Intervals: From **2** ft. to **14** ft., From **N/A** ft. to **N/A** ft., From **N/A** ft. to **N/A** ft.

What is the nearest source of possible contamination:
 Septic tank Lateral lines Pit privy Livestock pens Insecticide storage Other (specify below)
 Sewer lines Cesspool Sewage lagoon Fuel storage Abandoned water well
 Watertight sewer lines Seepage pit Feedyard Fertilizer storage Oil well/gas well

Direction from well **Northeast** Distance from well **<50-feet**

FROM	TO	LITHOLOGIC LOG	FROM	TO	LITHO. LOG (cont.) or PLUGGING INTERVALS
0	1	Grass roots silty clay dk brown	20	23	Sand med to coarse very moist
		moist soft plastic	23	24.5	Slightly clayey silt lt tan w/iron
1	8.5	Clay lt brown to yellow brown			oxide reddish brown streaks
		stiff slightly moist highly plastic			very moist soft non plastic
8.5	11.5	clay lt brown to yellow brown stiff	24.5	26	sand fine moist to very moist
		slightly moist highly plastic	26	31	" " med to coarse saturated
11.5	13.5	clayey sandy silt lt brown moist			
		soft trace to no plasticity			
13.5	17	sand fine lt gray staining			
17	20	" " fine to med			

7 CONTRACTOR'S OR LANDOWNER'S CERTIFICATION: This water well was constructed, reconstructed, or plugged under my jurisdiction and was completed on (mo/day/year) **3-7-2014** and this record is true to the best of my knowledge and belief.
Kansas Water Well Contractor's License No. **759** This Water Well Record was completed on (mo/day/year) **5/20/2014**
under the business name of **RAZEK Environmental, LLC** by (signature) *[Signature]*

INSTRUCTIONS: Use typewriter or ball point pen. **PLEASE PRESS FIRMLY** and **PRINT** clearly. Please fill in blanks and check the correct answers. Send one copy to Kansas Department of Health and Environment, Bureau of Water, Geology Section, 1000 SW Jackson St., Suite 420, Topeka, Kansas 66612-1367. Telephone 785-296-5524. Send one copy to WATER WELL OWNER and retain one for your records. Include fee of \$5.00 for each constructed well. Visit us at <http://www.kdheks.gov/waterwell/index.html>