

WATER WELL RECORD

Form WWC-5


Division of Water Resources App. No.

1 LOCATION OF WATER WELL: County: Sedgwick	Fraction NW ¼ NW ¼ NW ¼ NW ¼	Section Number 15	Township No. T 27 S	Range Number R 1 <input type="checkbox"/> E <input checked="" type="checkbox"/> W
--	---------------------------------	----------------------	------------------------	--

Street/Rural Address of Well Location; if unknown, distance & direction from nearest town or intersection: If at owner's address, check here .
 Phillips 66 on 13th
 7115 West 13th Street, Wichita, KS 67212

Global Positioning System (GPS) information:
 Latitude: 37.42' 29.94" (in decimal degrees)
 Longitude: 97.25' 32.09" (in decimal degrees)
 Elevation: 1342
 Datum: WGS 84, NAD 83, NAD 27
 Collection Method:
 GPS unit (Make/Model:)
 Digital Map/Photo, Topographic Map, Land Survey
 Est. Accuracy: <3 m, 3-5 m, 5-15 m, >15 m

2 WATER WELL OWNER: Kashif Khan
 RR#, Street Address, Box #: 7115 West 13th Street
 City, State, ZIP Code : Wichita, KS 67212

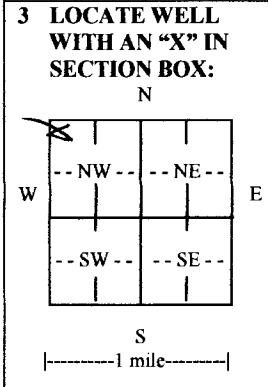

4 DEPTH OF COMPLETED WELL 31..... ft.
 Depth(s) Groundwater Encountered (1) 26..... ft. (2) N/A..... ft. (3) N/A..... ft.
 WELL'S STATIC WATER LEVEL 26.23..... ft. below land surface measured on mo/day/yr. 3/7/2014.....
 Pump test data: Well water was N/A..... ft. after N/A..... hours pumping N/A..... gpm
 EST. YIELD N/A..... gpm. Well water was N/A..... ft. after N/A..... hours pumping N/A..... gpm
 Bore Hole Diameter 8.25..... in. to 31..... ft., and N/A..... in. to N/A..... ft.
 WELL WATER TO BE USED AS: Public water supply Geothermal Injection well
 Domestic Feedlot Oil field water supply Dewatering Other (Specify below)
 Irrigation Industrial Domestic-lawn & garden Monitoring well MW-3
 Was a chemical/bacteriological sample submitted to Department? Yes No
 If yes, mo/day/yr sample was submitted N/A.....
 Water well disinfected? Yes No

5 TYPE OF CASING USED: Steel PVC Other.....
 CASING JOINTS: Glued Clamped Welded Threaded
 Casing diameter 2..... in. to 16..... ft., Diameter N/A..... in. to N/A..... ft., Diameter N/A..... in. to N/A..... ft.
 Casing height above land surface 0..... in., Weight N/A..... lbs./ft., Wall thickness or gauge No. Schedule 40.....
 TYPE OF SCREEN OR PERFORATION MATERIAL:
 Steel Stainless Steel PVC Other (Specify).....
 Brass Galvanized Steel None used (open hole)
 SCREEN OR PERFORATION OPENINGS ARE:
 Continuous slot Mill slot Gauze wrapped Torch cut Drilled holes None (open hole)
 Louvered shutter Key punched Wire wrapped Saw cut Other (specify).....
 SCREEN-PERFORATED INTERVALS: From 16..... ft. to 31..... ft., From N/A..... ft. to N/A..... ft.
 From N/A..... ft. to N/A..... ft., From N/A..... ft. to N/A..... ft.
 GRAVEL PACK INTERVALS: From 14..... ft. to 31..... ft., From N/A..... ft. to N/A..... ft.
 From N/A..... ft. to N/A..... ft., From N/A..... ft. to N/A..... ft.

6 GROUT MATERIAL: Neat cement Cement grout Bentonite Other Concrete 0 to 2-feet
 Grout Intervals: From 2..... ft. to 14..... ft., From N/A..... ft. to N/A..... ft., From N/A..... ft. to N/A..... ft.
 What is the nearest source of possible contamination:
 Septic tank Lateral lines Pit privy Livestock pens Insecticide storage Other (specify below)
 Sewer lines Cesspool Sewage lagoon Fuel storage Abandoned water well
 Watertight sewer lines Seepage pit Feedyard Fertilizer storage Oil well/gas well
 Direction from well West..... Distance from well <50-feet.....

FROM	TO	LITHOLOGIC LOG	FROM	TO	LITHO. LOG (cont.) or PLUGGING INTERVALS
0	0.5	5" Concrete 1" Sand	17.5	23.5	" " med to coarse
0.5	1.5	Silty clay dk brown moist med	23.5	25.5	" " fine moist
		stiff plastic	25.5	26.5	" " med to coarse very moist
1.5	8.5	" " brown to lt brown	26.5	31	" " saturated
8.5	12.5	Clay lt gray to brown moist stiff			
		highly plastic			
12.5	14	Clayey sandy silt lt brown			
		slightly moist stiff			
14	17.5	sand fine slightly moist stained			
		gray			

7 CONTRACTOR'S OR LANDOWNER'S CERTIFICATION: This water well was constructed, reconstructed, or plugged under my jurisdiction and was completed on (mo/day/year) 3-7-2014..... and this record is true to the best of my knowledge and belief.
 Kansas Water Well Contractor's License No. 759..... This Water Well Record was completed on (mo/day/year) 5/20/2014.....
 under the business name of RAZEK Environmental, LLC..... by (signature) *[Signature]*

INSTRUCTIONS: Use typewriter or ball point pen. PLEASE PRESS FIRMLY and PRINT clearly. Please fill in blanks and check the correct answers. * Send one copy to Kansas Department of Health and Environment, Bureau of Water, Geology Section, 1000 SW Jackson St., Suite 420, Topeka, Kansas 66612-1367. Telephone 785-296-5524. Send one copy to WATER WELL OWNER and retain one for your records. Include fee of \$5.00 for each constructed well. Visit us at <http://www.kdheks.gov/waterwell/index.html>