


WATER WELL RECORD Form WWC-5 KSA 82a-1212

1 LOCATION OF WATER WELL: <b>Sedgwick</b>	FRACTION <b>NE 1/4 SE 1/4 SE 1/4</b>	SECTION NUMBER <b>7</b>	TOWNSHIP NUMBER <b>T 27 S</b>	RANGE NUMBER <b>R 1W EW</b>
--	---	----------------------------	----------------------------------	--------------------------------

Distance and direction from nearest town or city street address of well if located within city?  
**1530 W. 13th St. N. Wichita, Kansas**

2 WATER WELL OWNER: <b>FAHEY, Mike</b>	Board of Agriculture, Division of Water Resource
RR#, ST. ADDRESS, BOX #: <b>1530 W. 13th St. N.</b>	Application Number:
CITY, STATE: <b>Wichita, Kansas</b>	ZIP CODE:

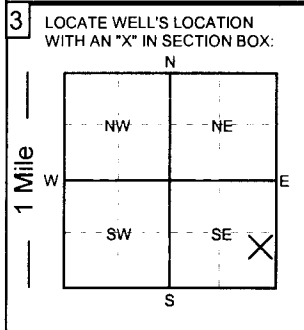

4 DEPTH OF COMPLETED WELL: **40** ft. ELEVATION: \_\_\_\_\_ ft.

Depth of groundwater Encountered: \_\_\_\_\_ ft.

WELL'S STATIC WATER LEVEL **12** FT. BELOW LAND SURFACE MEASURED ON **11/1/14**

Pump test data: Well water was \_\_\_\_\_ ft. after \_\_\_\_\_ hours of pumping @ \_\_\_\_\_ gpm

Est. Yield: \_\_\_\_\_ gpm Well water was \_\_\_\_\_ ft. after \_\_\_\_\_ hours of pumping @ \_\_\_\_\_ gpm

Bore Hole Diameter **12** in. to **40** ft. and \_\_\_\_\_ in. to \_\_\_\_\_ ft.

WELL WATER TO BE USED AS:  
 1. Domestic 3. Feedlot 5. Public water supply **7. Lawn and garden only** 9. Dewatering 11. Injection well  
 2. Irrigation 4. Industrial 6. Oil field water supply 8. Air conditioning 10. Monitoring well 12. Other (Specify below)

Was a chemical/bacteriological sample submitted to Department? **YES**  **NO**  ; If yes, what mo/day/yr was sample submitted \_\_\_\_\_

Was Water Well Disinfected?  **YES**  **NO**

5 TYPE OF CASING USED:

1. Steel	3. RPM (SR)	5. Wrought Iron	7. Fiberglass	9. Other (Specify below)	CASING JOINTS:	<b>Glued</b>	Threaded
<b>2. PVC</b>	4. ABS	6. Asbestos-Cement	8. Concrete tile	SDR-26		Welded	Clamped

Blank casing diameter **5** in. to **30** ft., Dia. \_\_\_\_\_ in. to \_\_\_\_\_ ft. Dia. \_\_\_\_\_ in. to \_\_\_\_\_ ft.

Casing height above land surface: **12** in., Weight: **2.35** lbs. / ft. Wall thickness or gauge No. **.214**

TYPE OF SCREEN OR PERFORATION MATERIAL:

1. Steel	3. Stainless Steel	5. Fiberglass	<b>7. PVC</b>	9. ABS	11. Other (specify)
2. Brass	4. Galvanized	6. Concrete Tile	8. RMP (SR)	10. Asbestos-Cement	12. None used (open hole)

SCREEN OR PERFORATION OPENINGS ARE:

1. Continuous slot	3. Mill slot	5. Gauzed wrapped	7. Torch cut	9. Drilled holes	11. None (open hole)
2. Louvered shutter	4. Key punched	6. Wire wrapped	<b>8. Saw cut</b>	10. Other (specify)	

SCREEN - PERFORATION INTERVAL From **30** ft. to **40** ft., From \_\_\_\_\_ ft. to \_\_\_\_\_ ft., From \_\_\_\_\_ ft. to \_\_\_\_\_ ft.

GRAVEL PACK INTERVALS: From **24** ft. to **40** ft., From \_\_\_\_\_ ft. to \_\_\_\_\_ ft., From \_\_\_\_\_ ft. to \_\_\_\_\_ ft.

6 GROUT MATERIALS: 1. Neat cement 2. Cement Grout 3. Bentonite Other **bentonite hole plug**

Grout Intervals: From **4** ft. to **24** ft., From \_\_\_\_\_ ft. to \_\_\_\_\_ ft., From \_\_\_\_\_ ft. to \_\_\_\_\_ ft.

What is the nearest source of possible contamination:

1. Septic tank	4. Lateral lines	7. Pit privy	10. Livestock pens	13. Insecticide storage	15. Oil well/Gas well
2. Sewer lines	5. Cess Pool	8. Sewage lagoon	11. Fuel storage	14. Abandon water well	16. Other (specify below)
<b>3. Watertight sewer line</b>	6. Seepage pit	9. Feed yard	12. Fertilizer storage		

Direction from well? **North** How many feet? **21 ft. plus**

From	To	LITHOLOGIC LOG	From	To	LITHOLOGIC LOG
0	3	<b>topsoil</b>			
3	8	<b>clay</b>			
8	15	<b>fine sand</b>			
15	40	<b>medium sand</b>			

7 Contractor's or Landowner's Certification: This water well was 1. **constructed** 2. reconstructed or 3. plugged under my jurisdiction and was completed on (mo/day/year) **11/01/2014** and this record is true to the best of my knowledge and belief.

Kansas Water Well Contractor's License No. **236** This water well record was completed on (mo/day/year) **11/03/2014**

under the business name of **Harp Well and Pump Service** by (signature) *Todd S. Harp*