


WATER WELL RECORD Form WWC-5 KSA 82a-1212

1 LOCATION OF WATER WELL: Sedgwick FRACTION: NE 1/4 SW 1/4 SW 1/4 SECTION NUMBER: 5 TOWNSHIP NUMBER: T 27 S RANGE NUMBER: R 1W E/W

Distance and direction from nearest town or city street address of well if located within city? 10011 W. Greenspoint Wichita, Kansas

2 WATER WELL OWNER: MAURER, Sam Board of Agriculture, Division of Water Resource RR#.ST. ADDRESS,BOX #: 10011 W. Greenspoint CITY, STATE: Wichita, Kansas ZIP CODE: Application Number:

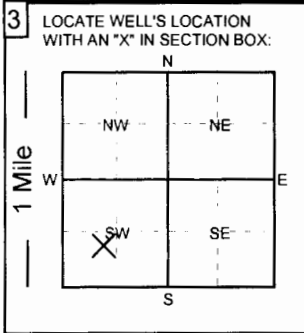

4 DEPTH OF COMPLETED WELL: 67 ft. ELEVATION: WELL'S STATIC WATER LEVEL: 21 FT. BELOW LAND SURFACE MEASURED ON 11/21/14

5 TYPE OF CASING USED: 1. Steel 2. PVC 3. RPM (SR) 4. ABS 5. Wrought Iron 6. Asbestos-Cement 7. Fiberglass 8. Concrete tile 9. Other (Specify below) SDR-26 CASING JOINTS: Glued, Threaded, Welded, Clamped

6 GROUT MATERIALS: 1. Neat cement 2. Cement Grout 3. Bentonite Other bentonite hole plug Grout intervals: From 4 ft. to 24 ft.

Table with 6 columns: From, To, Lithologic Log, From, To, Lithologic Log. Rows show soil layers: 0-3 topsoil, 3-18 clay, 18-40 fine sand, 40-60 medium sand, 60-67 clay.

7 Contractor's or Landowner's Certification: This water well was 1. constructed 2. reconstructed or 3. plugged under my jurisdiction and was completed on (mo/day/year) 11/21/2014