

WATER WELL PLUGGING RECORD Form WWC-5P KSA 82a-1212 ID NO.

1 LOCATION OF WATER WELL: Fraction Section Number Township Number Range Number
County: SEDGWICK 1/4 NW 1/4 SE 1/4 SE 1/4 3 T 27 S 1 ☐ E ☒ W

Street/Rural Address of Well Location; if unknown, distance & direction from nearest town or intersection: If at owner's address, check here ☒

Global Positioning Systems (GPS) information:

Latitude: 37°43'35.68"N (in decimal degrees)

Longitude: 97°24'43.11"W (in decimal degrees)

Elevation: 1332

Datum: ☒ WGS84, ☐ NAD83, ☐ NAD27

Collection Method:


☐ GPS unit (Make/Model: _____)

☒ Digital Map/Photo, ☐ Topographic Map, ☐ Land Survey

Est. Accuracy: ☐ < 3 m, ☐ 3-5 m, ☒ 5-15 m, ☐ > 15 m

2 WATER WELL OWNER: Superior Self Storage of Wichita, LLC
RR#, St. Address, Box #: 5825 W 23rd St N
City, State ZIP Code: Wichita, KS 67205

3 MARK WELL'S LOCATION WITH AN "X" IN SECTION BOX:

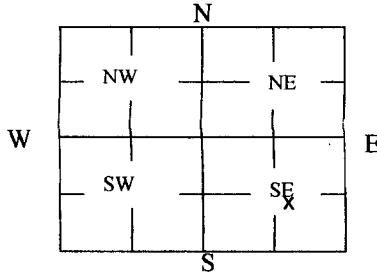

4 DEPTH OF WELL 19 ft.

WELL'S STATIC WATER LEVEL 12 ft

WELL WAS USED AS:

☒ Domestic
☐ Irrigation
☐ Feedlot
☐ Industrial

☐ Public Water Supply
☐ Oil Field Water Supply
☐ Domestic (Lawn & Garden)
☐ Air Conditioning

☐ Dewatering
☐ Monitoring
☐ Injection Well
☐ Other _____

Was a chemical/bacteriological sample submitted to Department? Yes ☐ No ☒

5 TYPE OF BLANK CASING USED:

☒ Steel ☐ RMP (SR) ☐ Wrought ☐ Fiberglass ☐ Other (Specify below)
☐ PVC ☐ ABS ☐ Asbestos-Cement ☐ Concrete Tile

Blank casing diameter 1.25 in. Was casing pulled? Yes ☐ No ☒ If yes, how much _____

Casing height above or below land surface 0 in. Flush w/ concrete floor

6 GROUT PLUG MATERIAL:

☒ Neat cement ☐ Cement grout ☐ Bentonite ☐ Other _____

Grout Plug Intervals: From _____ ft. to _____ ft., From _____ ft. to _____ ft., From _____ ft. to _____ ft.

What is the nearest source of possible contamination:

☒ Septic tank ☐ Seepage pit ☐ Fuel storage ☐ Other (specify below)
☐ Sewer lines ☐ Pit privy ☐ Fertilizer storage
☐ Watertight sewer lines ☐ Sewage lagoon ☐ Insecticide storage
☐ Lateral lines ☐ Feedyard ☐ Abandoned water well Direction from well? west
☐ Cess pool ☐ Livestock pens ☐ Oil well/Gas well How many feet? 55'

FROM	TO	PLUGGING MATERIALS	FROM	TO	PLUGGING MATERIALS
19'3"	0	Neat Cement			

7 CONTRACTOR'S OR LANDOWNER'S CERTIFICATION: This water well was plugged under my jurisdiction and was completed on (mo/day/year) 09/29/2014 and this record is true to the best of my knowledge and belief. Kansas Water Well Contractor's License No. N/A. This Water Well Record was completed on (mo/day/year) 09/29/2014 under the business name of Superior Self Storage of Wichita, LLC by (signature) Francis P. Hutchinson

INSTRUCTIONS: Use typewriter or ballpoint pen. Please press firmly and print clearly. Please fill in blanks, underline or circle the correct answers. Send top three copies to Kansas Department of Health and Environment, Bureau of Water, Geology Section, 1000 SW Jackson St., Ste. 420, Topeka, Kansas 66612-1367. Telephone: 785/296-5524. Send one to Water Well Owner and retain one for your records. Visit us at <http://www.kdheks.gov/waterwell/index.html>.

South building