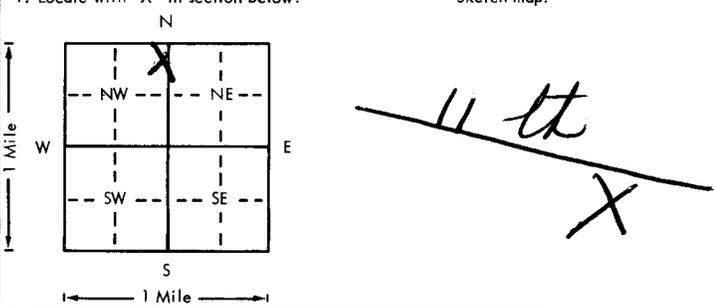


USE TYPEWRITER OR BALL POINT PEN-PRESS FIRMLY, PRINT CLEARLY.

WATER WELL RECORD
KSA 82a-1201-1215

Kansas Department of Health and Environment-Division of Environment (Water well Contractors) Topeka, Kansas 66620

1. Location of well: County <u>Sedgewick</u> Fraction <u>NE 1/4 NE 1/4 NW 1/4</u> Section number <u>14</u> Township number <u>T 27 S R 1 E W</u> Range number <u>1</u>	
2. Distance and direction from nearest town or city: Street address of well location if in city: <u>5103 W 11th</u>	
3. Owner of well: <u>Smith & Synn Hurst</u> R.R. or street: <u>6316</u> City, state, zip code: <u>Wichita KS 67208</u>	
4. Locate with "X" in section below: Sketch map: 	
6. Bore hole dia. <u>5.28</u> in. Completion date: <u>6/14/80</u> Well depth: <u>28</u> ft.	
7. <input checked="" type="checkbox"/> Cable tool <input checked="" type="checkbox"/> Rotary <input type="checkbox"/> Driven <input type="checkbox"/> Dug <input type="checkbox"/> Hollow rod <input type="checkbox"/> Jetted <input type="checkbox"/> Bored <input type="checkbox"/> Reverse rotary	
8. Use: <input checked="" type="checkbox"/> Domestic <input type="checkbox"/> Public supply <input type="checkbox"/> Industry <input type="checkbox"/> Irrigation <input type="checkbox"/> Air conditioning <input type="checkbox"/> Stock <input type="checkbox"/> Lawn <input type="checkbox"/> Oil field water <input type="checkbox"/> Other	
9. Casing: <u>Stupac</u> Height: <u>92</u> in. Threading: <u>Welded</u> Surface: <u>Surface</u> RMP: <u>PVC</u> Weight: <u>100</u> lbs./ft. Dia. <u>5.28</u> in. to <u>28</u> ft. depth Wall Thickness: <u>1/4</u> inches or gage No. <u>1/4</u>	
5. Type and color of material	
From To	
<u>Brown Sand</u> 0 10	
<u>White Sand</u> 10 28	
10. Screen: Manufacturer's name: <u>Oremae</u> Type: <u>100</u> Dia.: <u>5</u> Slot/gauze: <u>Slot</u> Length: <u>2.8</u> Set between: <u>2.3</u> ft. and <u>2.8</u> ft. Gravel pack? <u>No</u> Size range of material: _____	
11. Static water level: <u>16</u> ft. below land surface Date: <u>6/10/80</u>	
12. Pumping level below land surfaces: _____ ft. after _____ hrs. pumping _____ g.p.m. Estimated maximum yield: <u>10</u> g.p.m.	
13. Water sample submitted: _____ mo./day/yr. Yes <input checked="" type="checkbox"/> No <input type="checkbox"/> Date: _____	
14. Well head completion: <input checked="" type="checkbox"/> Pitless adapter _____ inches above grade	
15. Well grouted? <u>Yes</u> With: <input checked="" type="checkbox"/> Neat cement <input type="checkbox"/> Bentonite <input type="checkbox"/> Concrete Depth: From <u>2</u> ft. to <u>12</u> ft.	
16. Nearest source of possible contamination: _____ ft. Direction: <u>East</u> Well disinfected upon completion? <input checked="" type="checkbox"/> Yes <input type="checkbox"/> No	
17. Pump: _____ Not installed Manufacturer's name: <u> Gould</u> Model number: _____ HP: <u>1/2</u> Volts: <u>230</u> Length of drop pipe: <u>21</u> ft. capacity: <u>10</u> g.p.m. Type: <input checked="" type="checkbox"/> Submersible <input type="checkbox"/> Turbine <input type="checkbox"/> Jet <input type="checkbox"/> Reciprocating <input type="checkbox"/> Centrifugal <input type="checkbox"/> Other	
18. Elevation: _____ 19. Remarks: _____	
20. Water well contractor's certification: This well was drilled under my jurisdiction and this report is true to the best of my knowledge and belief. Signed: <u>Just Drilling 313A</u> Business name: <u>257 N Saline</u> License No.: _____ Address: <u>Wagon Bar</u> Signed: <u>June 15/80</u> Authorized representative	

Forward the white, blue and pink copies to the Department of Health and Environment

Form WWC-5

27 - 14 NE NE NW
 T 27 S R 1 E W
 Sec 14