USE TYPEWRITER OR BALL POINT PEN-PRESS FIRMLY, PRINT CLEARLY.

WATER WELL RECORD
KSA 82a-1201-1215

Kansas Department of Health and Environment-Division of Environment
(Water well Contractors)
Topeka, Kansas 66620

1. Location of well:	County	Fraction	Section number	Township number	Range number
	Sedgwick	1/4 SW 1/4 Sw 1/4	10	T 27 S	R 1 W

2. Distance and direction from nearest town or city: #2 one block north of
Street address of well location if in city: 13th street and 1/4 east of Ridge Road Wichita, Kansas

3. Owner of well: West Urban Little League Inc.
R.R. or street: 10008 West Ninth street
City, state, zip code: Wichita, Kansas

4. Locate with "X" in section below:

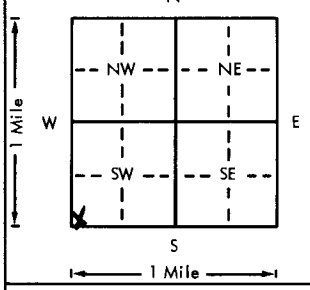

6. Bore hole dia. 11 in. Completion date
Well depth 51 ft. 7-27-76

7. __ Cable tool X Rotary __ Driven __ Dug
__ Hollow rod __ Jetted __ Bored __ Reverse rotary

8. Use: __ Domestic __ Public supply __ Industry
X Irrigation __ Air conditioning __ Stock
X Lawn __ Oil field water __ Other

9. Casing: Material styrene Height: Above or below
Threaded __ Welded gl Surface 12 in.
RMP X PVC __ Weight __ lbs./ft.
Dia. 5 in. to 51 ft. depth Wall Thickness: inches or
Dia. __ in. to __ ft. depth gage No. .200

5. Type and color of material	From	To
Sandy Soil	0	3
Medium Sand	3	14
Clay	14	15
Medium Sand	15	50
Shale	50	51
(Use a second sheet if needed)		

10. Screen: Manufacturer's name Sunflower Plastic
Type styrene Dia. 5"
Slot .06 Length 20'
Set between 31 ft. and 51 ft.
ft. and ft.
Gravel pack? yes Size range of material 1-1/8"

11. Static water level: mo./day/yr.
20 ft. below land surface Date 7-27-76

12. Pumping level below land surfaces:
ft. after hrs. pumping g.p.m.
ft. after hrs. pumping g.p.m.
Estimated maximum yield g.p.m.

13. Water sample submitted: mo./day/yr.
__ Yes __ No Date

14. Well head completion:
__ Pitless adapter 12 capped Inches above grade

15. Well grouted? yes
With: __ Neat cement __ Bentonite X Concrete
Depth: From 40" ft. to 14 ft.

16. Nearest source of possible contamination:
ft. 50 Direction South Type Septic Tank
Well disinfected upon completion? X Yes __ No

17. Pump: X Not installed
Manufacturer's name
Model number HP Volts
Length of drop pipe ft. capacity g.p.m.
Type:
__ Submersible __ Turbine
__ Jet __ Reciprocating
__ Centrifugal __ Other

18. Elevation:

Topography:
__ Hill
__ Slope
__ Upland
__ Valley

19. Remarks:
Flat Ground
Water to be used for watering baseball field.

20. Water well contractor's certification:
This well was drilled under my jurisdiction and this report is true to the best of my knowledge and belief.
Harp Well & Pump 236
Business name License No.
Address Wichita, Kansas
Signed M. Arnold Date 8-9-76
Authorized representative

T 27 R 1 (E) (W) Sec 10 1/4 1/4 1/4 SWSW

Forward the white, blue and pink copies to the Department of Health and Environment

Form WWC-5

M1-1023