


1 LOCATION OF WATER WELL: Sedgwick	FRACTION E 1/2 SW 1/4 SE 1/4	Section Number 3	Township Number T 27 S	Range Number R 1W E/W
--	--	----------------------------	----------------------------------	---------------------------------

Distance and direction from nearest town or city street address of well if located within city?

Lakeway and 21st North Wichita, Kansas

WATER WELL OWNER: WICHITA, CITY OF	RR#, ST. ADDRESS, BOX #: 455 N. Main	Board of Agriculture, Division of Water Resource
CITY, STATE, ZIP CODE: Wichita, Kansas	67203	Application Number: 980166

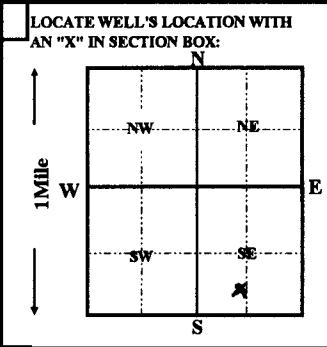

4 DEPTH OF COMPLETED WELL 50 ft.	ELEVATION:
Depth(s) groundwater Encountered 1 ft.	2 ft.
WELL'S STATIC WATER LEVEL 12 FT. BELOW LAND SURFACE MEASURED ON	09/01/1998
Pump test data:	Well water was
Est. Yield	gpm: Well water was
Bore Hole Diameter	12 in. to 50 ft.
WELL WATER TO BE USED AS:	5 Public water supply
1 Domestic	3 Feedlot
2 Irrigation	4 Industrial
3 Feedlot	6 Oil field water supply
4 Industrial	7 Lawn and garden only
5 Public water supply	8 Air conditioning
6 Oil field water supply	9 Dewatering
7 Lawn and garden only	10 Monitoring well
8 Air conditioning	11 Injection well
9 Dewatering	12 Other (Specify below)
10 Monitoring well	

Was a chemical/bacteriological sample submitted to Department? Yes No ; If yes, mo/day/yr sample was submitted

Water Well Disinfected? Yes No

5 TYPE OF CASING USED:	5 Wrought iron	8 Concrete tile	CASING JOINTS:	Glued <input checked="" type="checkbox"/> Clamped
1 Steel	3 RMP (SR)	6 Asbestos-Cement	9 Other (Specify below)	Welded
2 PVC	4 ABS	7 Fiberglass	SDR-26	Threaded
Blank casing Diameter	8 in. to 20 ft., Dia	weight	5.52 lbs. / ft.	Wall thickness or gauge No. .332
Casing height above land surface	12 in.			
TYPE OF SCREEN OR PERFORATION MATERIAL:	5 Fiberglass	7 PVC	10 Asbestos-cement	
1 Steel	3 Stainless Steel	8 RMP (SR)	11 other (specify)	
2 Brass	4 Galvanized steel	9 ABS	12 None used (open hole)	
SCREEN OR PERFORATION OPENING ARE:	5 Gauzed wrapped	8 Saw cut	11 None (open hole)	
1 Continous slot	3 Mill slot	9 Drilled holes		
2 Louvered shutter	4 Key punched	10 Other (specify)		
SCREEN-PERFORATION INTERVALS:	from 20 ft. to 50 ft., From	ft. to	ft.	
GRAVEL PACK INTERVALS:	from 20 ft. to 50 ft., From	ft. to	ft.	

6 GROUT MATERIAL:	1 Neat cement	2 Cement grout	3 Bentonite	4 Other bentonite hole plug
Grout Intervals:	From 0 ft. to 20 ft. From	ft. to	ft. From	ft. to
What is the nearest source of possible contamination:	1 Septic tank	4 Lateral lines	7 Pit privy	10 Livestock pens
	2 Sewer lines	5 Cess pool	8 Sewage lagoon	11 Fuel storage
	3 Watertight sewer lines	6 Seepage pit	9 Feedyard	12 Fertilizer storage
				13 Insecticide storage
				14 Abandon water well
				15 Oil well/Gas well
				16 Other (specify below)
				None Apparent

FROM	TO	LITHOLOGIC LOG	FROM	TO	PLUGGING INTERVALS
0	10	fine sand			
10	30	medium sand			
30	47	coarse sand			
47	50	shale			

7 CONTRACTOR'S OR LANDOWNER'S CERTIFICATION: This water well was (1) constructed, (2) reconstructed, or (3) plugged under my jurisdiction and was completed on (mo/day/year) 09/01/1998 and this record is true to the best of my knowledge and belief. Kansas Water Well Contractor's License No. 236 This Water Well Record was completed on (mo/day/yr) 09/02/98 Under the business name of Harp Well & Pump Service, Inc. by (signature) Todd S. Harp
--