

State

WATER WELL RECORD Form WWC-5


Division of Water Resources App. No.

Well ID

Original Record Correction Change in Well Use

1 LOCATION OF WATER WELL: County: Sedgewick Fraction SW 1/4 NW 1/4 NE 1/4 NW 1/4 Section Number 14 Township Number T 27 S Range Number R 1 E W

2 WELL OWNER: Last Name: Guerrero First: David Business Address: 1319 N. Clara City: Wichita State: KS ZIP: 67212 Street or Rural Address where well is located: [X]

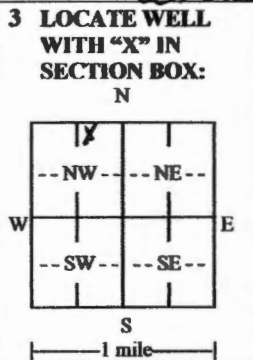

4 DEPTH OF COMPLETED WELL: 50 ft. Depth(s) Groundwater Encountered: 1) 14 ft. 2) ... 3) ... 4) ... WELL'S STATIC WATER LEVEL: 9/30/15

5 Latitude: 37.708175 Longitude: 97.4026803 Horizontal Datum: [X] NAD 83 Source for Latitude/Longitude: [X] GPS

6 Elevation: ... ft. Source: [X] Land Survey [X] GPS [X] Topographic Map

7 WELL WATER TO BE USED AS: 1. Domestic [X] Household [X] Lawn & Garden [X] Livestock 2. Irrigation 3. Feedlot 4. Industrial 5. Public Water Supply 6. Dewatering 7. Aquifer Recharge 8. Monitoring 9. Environmental Remediation 10. Oil Field Water Supply 11. Test Hole 12. Geothermal 13. Other

Was a chemical/bacteriological sample submitted to KDHE? [X] No If yes, date sample was submitted: Water well disinfected? [X] Yes

8 TYPE OF CASING USED: [X] PVC CASING JOINTS: [X] Glued Casing diameter: 5 in. to 5.2 ft. Casing height above land surface: 12 in. Weight: 1.60 lbs./ft. Wall thickness or gauge No. 26

TYPE OF SCREEN OR PERFORATION MATERIAL: [X] PVC [X] Mill Slot [X] None used (open hole)

SCREEN OR PERFORATION OPENINGS ARE: [X] Mill Slot [X] None (Open Hole)

SCREEN-PERFORATED INTERVALS: From 30 ft. to 50 ft. GRAVEL PACK INTERVALS: From 24 ft. to 50 ft.

9 GROUT MATERIAL: [X] Bentonite Grout intervals: From 4 ft. to 24 ft.

Nearest source of possible contamination: [X] Watertight Sewer Lines Distance from well? West 25' ft.

Table with columns: FROM, TO, LITHOLOGIC LOG, FROM, TO, LITHO. LOG (cont.) or PLUGGING INTERVALS. Rows: 0-2 Top Soil, 2-18 Clay, 18-50 Med Coarse Sand.

11 CONTRACTOR'S OR LANDOWNER'S CERTIFICATION: This water well was [X] constructed, [ ] reconstructed, or [ ] plugged under my jurisdiction and was completed on (mo-day-year) 9/30/15 and this record is true to the best of my knowledge and belief. Kansas Water Well Contractor's License No. 611 This Water Well Record was completed on (mo-day-year) 10-10-15 under the business name of Chase Plumbing Signature: D. Chase