

1 LOCATION OF WATER WELL: Fraction NE 1/4 SW 1/4 SW 1/4 SW 1/4 Section Number 3 Township Number T 27 S Range Number E V
 County: Sedgewick


Street/Rural Address of Well Location; if unknown, distance & direction from nearest town or intersection: If at owner's address, check here 7120 West 21st North
Wichita, KS 67212

Global Positioning Systems (GPS) information:
 Latitude: 37.7238 (in decimal degrees)
 Longitude: -97.425844 (in decimal degrees)
 Elevation: 1332
 Datum: WGS84, NAD83, NAD27
Collection Method:

2 WATER WELL OWNER: Quik Trip Corporation
 RR#, St. Address, Box #: 4705 S 129th East Ave
 City, State ZIP Code: Tulsa, OK 74134

GPS unit (Make/Model: _____)
 Digital Map/Photo, Topographic Map, Land Survey
 Est. Accuracy: < 3 m, 3-5 m, 5-15 m, > 15 m

3 MARK WELL'S LOCATION WITH AN "X" IN SECTION BOX:

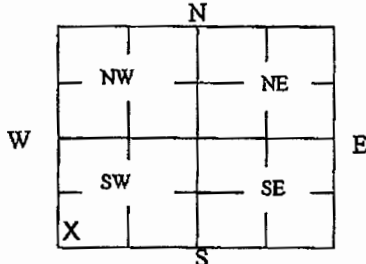

4 DEPTH OF WELL 51' ft.
WELL'S STATIC WATER LEVEL 15.5' ft

WELL WAS USED AS:

- Domestic
- Public Water Supply
- Dewatering
- Irrigation
- Oil Field Water Supply
- Monitoring
- Feedlot
- Domestic (Lawn & Garden)
- Injection Well
- Industrial
- Air Conditioning
- Other _____

Was a chemical/bacteriological sample submitted to Department? Yes No

5 TYPE OF BLANK CASING USED:

- Steel
- RMP (SR)
- Wrought
- Fiberglass
- Other (Specify below) _____
- PVC
- ABS
- Asbestos-Cement
- Concrete Tile

Blank casing diameter 4" in. Was casing pulled? Yes No If yes, how much _____
 Casing height above or below land surface 36" in.

6 GROUT PLUG MATERIAL: Neat cement Cement grout Bentonite Other _____

Grout Plug Intervals: From 3' ft. to 51' ft., From _____ ft. to _____ ft., From _____ ft. to _____ ft.

What is the nearest source of possible contamination:

- Septic tank
 - Seepage pit
 - Fuel storage
 - Other (specify below) _____
 - Sewer lines
 - Pit privy
 - Fertilizer storage
 - Watertight sewer lines
 - Sewage lagoon
 - Insecticide storage
 - Lateral lines
 - Feedyard
 - Abandoned water well
 - Oil well/Gas well
 - Cess pool
 - Livestock pens
- Direction from well? Southeast
 How many feet? 150'

FROM	TO	PLUGGING MATERIALS	FROM	TO	PLUGGING MATERIALS
0'	3'	Clay Soil			
3'	51'	Bentonite			

7 CONTRACTOR'S OR LANDOWNER'S CERTIFICATION: This water well was plugged under my jurisdiction and was completed on (mo/day/year) 04/22/2016 and this record is true to the best of my knowledge and belief. Kansas Water Well Contractor's License No. 851. This Water Well Record was completed on (mo/day/year) 05/01/2016 under the business name of GHD Services, Inc by (signature) [Signature]

INSTRUCTIONS: Use typewriter or ballpoint pen. Please press firmly and print clearly. Please fill in blanks, underline or circle the correct answers. Send top three copies to Kansas Department of Health and Environment, Bureau of Water, Geology Section, 1000 SW Jackson St., Ste. 420, Topeka, Kansas 66612-1367. Telephone: 785/296-5524. Send one to Water Well Owner and retain one for your records. Visit us at <http://www.kdheks.gov/waterwell/index.html>.