

state

WATER WELL RECORD Form WWC-5


Division of Water Resources App. No.

Well ID

- Original Record Correction Change in Well Use

1 LOCATION OF WATER WELL: County: Sedgewick Fraction NW 1/4 SE 1/4 NE 1/4 SE 1/4 Section Number 5 Township Number T 27 S Range Number R 1 E NW

2 WELL OWNER: Last Name Weatherston First: Wendy Street or Rural Address where well is located (if unknown, distance and direction from nearest town or intersection): If at owner's address, check here: [X] Business: Address: 2421 N Baytree St City: Wichita State: ZIP: 67205

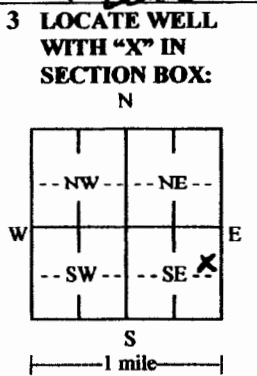

3 LOCATE WELL WITH 'X' IN SECTION BOX: 4 DEPTH OF COMPLETED WELL: 60 ft. Depth(s) Groundwater Encountered: 1) 24 ft. 2) ft. 3) ft. or 4) Dry Well WELL'S STATIC WATER LEVEL: 24 ft. [X] below land surface, measured on (mo-day-yr) [X] above land surface, measured on (mo-day-yr) 7-16-15 Pump test data: Well water was ft. after hours pumping gpm. Well water was ft. after hours pumping gpm. Estimated Yield: 2.2 gpm Bore Hole Diameter: 1.2 in. to ft. and in. to ft.

5 Latitude: 37.72759962 (decimal degrees) Longitude: 97.44628691 (decimal degrees) Datum: [X] WGS 84 [X] NAD 83 [] NAD 27 Source for Latitude/Longitude: [] GPS (unit make/model:) (WAAS enabled? [] Yes [] No) [] Land Survey [] Topographic Map [] Online Mapper:

6 Elevation: ft. [] Ground Level [] TOC Source: [] Land Survey [] GPS [] Topographic Map [] Other

7 WELL WATER TO BE USED AS: 1. Domestic: [] Household [X] Lawn & Garden [] Livestock [] Irrigation [] Feedlot [] Industrial 5. [] Public Water Supply: well ID 6. [] Dewatering: how many wells? 7. [] Aquifer Recharge: well ID 8. [] Monitoring: well ID 9. Environmental Remediation: well ID [] Air Sparge [] Soil Vapor Extraction [] Recovery [] Injection 10. [] Oil Field Water Supply: lease 11. Test Hole: well ID [] Cased [] Uncased [] Geotechnical 12. Geothermal: how many bores? a) Closed Loop [] Horizontal [] Vertical b) Open Loop [] Surface Discharge [] Inj. of Water 13. [] Other (specify):

Was a chemical/bacteriological sample submitted to KDHE? [] Yes [X] No If yes, date sample was submitted: Water well disinfected? [X] Yes [] No

8 TYPE OF CASING USED: [] Steel [X] PVC [] Other CASING JOINTS: [X] Glued [] Clamped [] Welded [] Threaded Casing diameter 5 in. to 6.0 ft., Diameter in. to ft., Diameter in. to ft. Casing height above land surface 1.2 in. Weight 16.0 lbs./ft. Wall thickness or gauge No. 2.6

TYPE OF SCREEN OR PERFORATION MATERIAL: [] Steel [] Stainless Steel [] Fiberglass [X] PVC [] Other (Specify) [] Brass [] Galvanized Steel [] Concrete tile [] None used (open hole)

SCREEN OR PERFORATION OPENINGS ARE: [] Continuous Slot [X] Mill Slot [] Gauze Wrapped [] Torch Cut [] Drilled Holes [] Other (Specify) [] Louvered Shutter [] Key Punched [] Wire Wrapped [] Saw Cut [] None (Open Hole)

SCREEN-PERFORATED INTERVALS: From 4.0 ft. to 6.0 ft., From ft. to ft., From ft. to ft. GRAVEL PACK INTERVALS: From 2.4 ft. to 6.0 ft., From ft. to ft., From ft. to ft.

9 GROUT MATERIAL: [] Neat cement [] Cement grout [X] Bentonite [] Other Grout Intervals: From 4 ft. to 2.4 ft., From ft. to ft., From ft. to ft.

Nearest source of possible contamination: [] Septic Tank [] Lateral Lines [] Pit Privy [] Livestock Pens [] Insecticide Storage [] Sewer Lines [] Cess Pool [] Sewage Lagoon [] Fuel Storage [] Abandoned Water Well [X] Watertight Sewer Lines [] Seepage Pit [] Feedyard [] Fertilizer Storage [] Oil Well/Gas Well [] Other (Specify) Direction from well? West Distance from well? 75' ft.

Table with columns: FROM, TO, LITHOLOGIC LOG, FROM, TO, LITH. LOG (cont.) or PLUGGING INTERVALS. Rows: 0-2 Top Soil, 2-24 Clay, 24-60 med-Sand. Notes section below.

11 CONTRACTOR'S OR LANDOWNER'S CERTIFICATION: This water well was [X] constructed, [] reconstructed, or [] plugged under my jurisdiction and was completed on (mo-day-year) 7/16/15 and this record is true to the best of my knowledge and belief. Kansas Water Well Contractor's License No. 611 This Water Well Record was completed on (mo-day-year) 8/15/15 under the business name of Chase Drilling