

WATER WELL RECORD

Form WWC-5

Division of Water Resources App. No.


MW-3

1 LOCATION OF WATER WELL: County: Sedgwick	Fraction EW 1/4 SW 1/4 SW 1/4 SE 1/4	Section Number 09	Township No. T 27 S	Range Number R 01 <input checked="" type="checkbox"/> E <input type="checkbox"/> W
---	--	-----------------------------	-------------------------------	--

Street/Rural Address of Well Location; if unknown, distance & direction from nearest town or intersection: If at owner's address, check here
1000 E. 13th Street N., Wichita, KS

Global Positioning System (GPS) information:
 Latitude: **37.708587** (in decimal degrees)
 Longitude: **97.326065** (in decimal degrees)
 Elevation:
 Datum: WGS 84, NAD 83, NAD 27
 Collection Method:
 GPS unit (Make/Model: **Google Earth**)
 Digital Map/Photo, Topographic Map, Land Survey
 Est. Accuracy: < 3 m, 3-5 m, 5-15 m, > 15 m

2 WATER WELL OWNER: **Scott & Lindsay Hall**
 RR#, Street Address, Box #: **1221 East Murdock**
 City, State, ZIP Code : **Wichita, KS 67214**

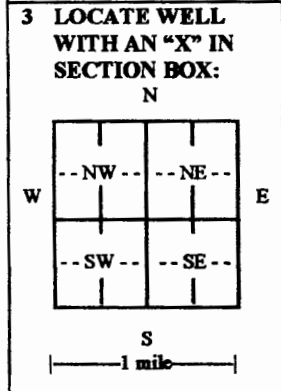

4 DEPTH OF COMPLETED WELL **25.0'** ft.
 Depth(s) Groundwater Encountered (1) ft. (2) ft. (3) ft.
 WELL'S STATIC WATER LEVEL **13.49'** ft. below land surface measured on mo/day/yr. **9/8/15**
 Pump test data: Well water was ft. after hours pumping gpm
 EST. YIELD gpm. Well water was ft. after hours pumping gpm
 Bore Hole Diameter **8.50"** in. to **25.0'** ft., and in. to ft.
 WELL WATER TO BE USED AS: Public water supply Geothermal Injection well
 Domestic Feedlot Oil field water supply Dewatering Other (Specify below)
 Irrigation Industrial Domestic-lawn & garden Monitoring well
 Was a chemical/bacteriological sample submitted to Department? Yes No
 If yes, mo/day/yr sample was submitted.....
 Water well disinfected? Yes No

5 TYPE OF CASING USED: Steel PVC Other
 CASING JOINTS: Glued Clamped Welded Threaded
 Casing diameter **2.0"** in. to **10.0'** ft., Diameter in. to ft., Diameter in. to ft.
 Casing height above land surface **Flush** in., Weight lbs./ft., Wall thickness or gauge No. **Sch. 40**
 TYPE OF SCREEN OR PERFORATION MATERIAL:
 Steel Stainless Steel PVC Other (Specify)
 Brass Galvanized Steel None used (open hole)
 SCREEN OR PERFORATION OPENINGS ARE:
 Continuous slot Mill slot Gauze wrapped Torch cut Drilled holes None (open hole)
 Louvered shutter Key punched Wire wrapped Saw cut Other (specify)
 SCREEN-PERFORATED INTERVALS: From **10.0'** ft. to **25.0'** ft., From ft. to ft.
 GRAVEL PACK INTERVALS: From **8.0'** ft. to **25.0'** ft., From ft. to ft.
 From ft. to ft., From ft. to ft.

6 GROUT MATERIAL: Neat cement Cement grout Bentonite Other
 Grout Intervals: From **0** ft. to **1.0'** ft., From **1.0'** ft. to **8.0'** ft., From ft. to ft.
 What is the nearest source of possible contamination:
 Septic tank Lateral lines Pit privy Livestock pens Insecticide storage Other (specify below)
 Sewer lines Cesspool Sewage lagoon Fuel storage Abandoned water well
 Watertight sewer lines Seepage pit Feedyard Fertilizer storage Oil well/gas well
 Direction from well Distance from well

FROM	TO	LITHOLOGIC LOG	FROM	TO	LITHO. LOG (cont.) or PLUGGING INTERVALS
		See Boring Log			

7 CONTRACTOR'S OR LANDOWNER'S CERTIFICATION: This water well was constructed, reconstructed, or plugged under my jurisdiction and was completed on (mo/day/year) **09/02/2015** and this record is true to the best of my knowledge and belief. Kansas Water Well Contractor's License No. **606** This Water Well Record was completed on (mo/day/year) **01/27/2016** under the business name of **PSA Environmental Services, LLC** by (signature)

INSTRUCTIONS: Use typewriter or ball point pen. **PLEASE PRESS FIRMLY** and **PRINT** clearly. Please fill in blanks and check the correct answers. Send three copies (white, blue, pink) to Kansas Department of Health and Environment, Bureau of Water, Geology Section, 1000 SW Jackson St., Suite 420, Topeka, Kansas 66612-1367. Telephone 785-296-5522. Send one copy to WATER WELL OWNER and retain one for your records. Include fee of \$5.00 for each constructed well. Visit us at <http://www.kdheks.gov/waterwell/index.html>.

Boring Number:		MW-3		Page 1 of 1	
Location:		Southwest of excavation		Date Started:	9/2/2015
Site Address:		1000 East 13th Street North		Date Completed:	9/2/2015
		Wichita, Kansas 67214		Depth to Groundwater:	13.49
Project Number:		15-138728.3		Field Technician:	CN
Drill Rig Type:		Geoprobe 6620		Partner Engineering and Science, Inc.	
Sampling Equipment:		Hollow Stem Auger		611 Industrial Way West	
Borehole Diameter:		8.25		Eatontown, NJ 07724	
Depth	Sample	PID	USCS	Description	Notes
1		0.0			
2		0.0			
3		0.0			
4		0.0			
5		0.0	N/A	Fill material consisting of black clay, concrete, brick, wood and gravel; slightly moist	No odor/staining
6		0.0			
7		0.0			
8		0.0			
9		0.0			
10		0.0			
11		0.0			
12		0.0			
13		0.0		Tan medium sand; moist	Sweet odor
14		0.0			
15		0.0			
16		0.0			
17		0.0	SP		
18		0.0			
19		0.0			
20		0.0			
21		0.0		Coarse tan sand; saturated	Slight petroleum-like odor from 20.0 to 25.0 feet bgs
22		0.0			
23		0.0			
24		0.0			
25		0.0			

Well screened from 10.0 to 25.0 feet bgs.