


**WATER WELL RECORD Form WWC-5 KSA 82a-1212**

1 LOCATION OF WATER WELL: <b>Sedgwick</b>	FRACTION <b>NW 1/4 SW 1/4 NW 1/4</b>	SECTION NUMBER <b>27</b>	TOWNSHIP NUMBER <b>T 27 S</b>	RANGE NUMBER <b>R 1W E/W</b>
--	---	-----------------------------	----------------------------------	---------------------------------

Distance and direction from nearest town or city street address of well if located within city?  
**500 S. Ridge Road Wichita, Kansas**

2 WATER WELL OWNER: <b>RIB CRIB CORPORATION</b>	Board of Agriculture, Division of Water Resource
RR#,ST. ADDRESS,BOX #: <b>4535 S. Harvard Ave.</b>	Application Number:
CITY, STATE: <b>Tulsa, Oklahoma</b>	ZIP CODE: <b>74135</b>

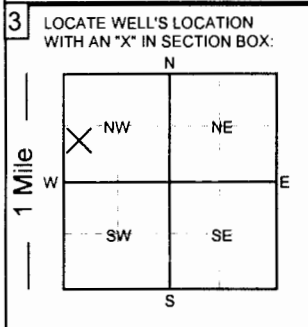

4 DEPTH OF <del>plugged</del> WELL: <b>65</b> ft.	ELEVATION:
Depth of groundwater Encountered:	ft.
WELL'S STATIC WATER LEVEL <b>25</b> FT. BELOW LAND SURFACE MEASURED ON <b>6/15/16</b>	
Pump test data: Well water was	ft. after hours of pumping @ gpm
Est. Yield: gpm	Well water was ft. after hours of pumping @ gpm
Bore Hole Diameter in. to ft. and in. to ft.	
WELL WATER USE USED AS:	
1. Domestic	3. Feedlot
5. Public water supply	7. <b>Lawn and garden only</b>
2. Irrigation	4. Industrial
6. Oil field water supply	8. Air conditioning
9. Dewatering	11. Injection well
10. Monitoring well	12. Other (Specify below)
Was a chemical/bacteriological sample submitted to Department? YES NO ; If yes, what mo/day/yr was sample submitted	
Was Water Well Disinfected? YES NO	

5 TYPE OF CASING USED:	1. Steel	3. RPM (SR)	5. Wrought Iron	7. Fiberglass	9. Other (Specify below)	CASING JOINTS: Glued	Threaded				
	2. <b>PVC</b>	4. ABS	6. Asbestos-Cement	8. Concrete tile		Welded	Clamped				
Blank casing diameter	<b>6</b> in.	to	ft.,	Dia.	in.	to	ft.,	Dia.	in.	to	ft.
Casing height below land surface:	<b>36</b> in.,	Weight:	lbs. / ft.	Wall thickness or gauge No.							
TYPE OF SCREEN OR PERFORATION MATERIAL:											
1. Steel	3. Stainless Steel	5. Fiberglass	7. PVC	9. ABS	11. Other (specify)	N/A					
2. Brass	4. Galvanized	6. Concrete Tile	8. RMP (SR)	10. Asbestos-Cement	12. None used (open hole)						
SCREEN OR PERFORATION OPENINGS ARE:											
1. Continuous slot	3. Mill slot	5. Gauzed wrapped	7. Torch cut	9. Drilled holes	11. None (open hole)						
2. Louvered shutter	4. Key punched	6. Wire wrapped	8. Saw cut	10. Other (specify)	N/A						
SCREEN - PERFORATION INTERVAL											
From	ft.	to	ft.,	From	ft.	to	ft.				
From	ft.	to	ft.,	From	ft.	to	ft.				
GRAVEL PACK INTERVALS:											
From	ft.	to	ft.,	From	ft.	to	ft.				
From	ft.	to	ft.,	From	ft.	to	ft.				

6 GROUT MATERIALS:	1. Neat cement	2. Cement Grout	3. Bentonite	Other	<b>bentonite hole plug</b>
Grout Intervals: From	<b>3</b> ft.	to	<b>23</b> ft.,	From	ft. to ft.,
What is the nearest source of possible contamination:					
1. Septic tank	4. Lateral lines	7. Pit privy	10. Livestock pens	13. Insecticide storage	15. Oil well/Gas well
2. Sewer lines	5. Cess Pool	8. Sewage lagoon	11. Fuel storage	14. Abandon water well	16. Other (specify below)
3. Watertight sewer line	6. Seepage pit	9. Feed yard	12. Fertilizer storage	How many feet?	

From	To	LITHOLOGIC LOG	From	To	LITHOLOGIC LOG
			<b>0</b>	<b>3</b>	<b>compacted clay</b>
			<b>3</b>	<b>23</b>	<b>bentonite hole plug</b>
			<b>23</b>	<b>65</b>	<b>chlorinated gravel</b>

7 Contractor's or Landowner's Certification: This water well was 1. <b>constructed</b> 2. <b>reconstructed</b> or 3. <b>plugged</b> under my jurisdiction and was completed on (mo/day/year) <b>6-15-16</b>	and this record is true to the best of my knowledge and belief.
Kansas Water Well Contractor's License No. <b>236</b>	This water well record was completed on (mo/day/year) <b>6-17-16</b>
under the business name of <b>Harp Well and Pump Service</b>	by (signature) <b>Todd S. Harp</b>