

State

WATER WELL RECORD Form WWC-5


Original Record Correction Change in Well Use

Division of Water Resources App. No. []

Well ID []

1 LOCATION OF WATER WELL: County: Sedgwick Fraction: 1/4 SW 1/4 NW 1/4 SW 1/4 Section Number: 31 Township Number: T 27 S Range Number: R 1 E W

2 WELL OWNER: Last Name: Fryman First: Angie Street or Rural Address where well is located: 2129 S. Milstead St City: Wichita State: KS ZIP: 67209

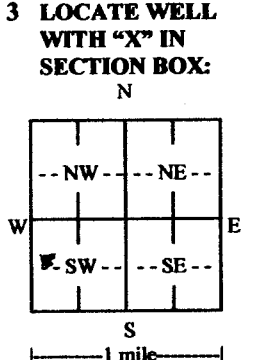

3 LOCATE WELL WITH 'X' IN SECTION BOX: N W E S 1 mile

4 DEPTH OF COMPLETED WELL: 140 ft. Depth(s) Groundwater Encountered: 1) 33 ft. 2) 51 ft. 3) 117 ft. or 4) Dry Well WELL'S STATIC WATER LEVEL: 33 ft. below land surface, measured on (mo-day-yr) Pump test data: Well water was 120 ft. after 2 hours pumping 75 gpm Well water was 140 ft. after 2 hours pumping Estimated Yield: 75 gpm Bore Hole Diameter: 1.2 in. to 1.4 in.

5 Latitude: Longitude: Datum: WGS 84 NAD 83 NAD 27 Source for Latitude/Longitude: GPS (unit make/model: WAAS enabled? Yes No) Land Survey Topographic Map Online Mapper: Elevation: Ground Level TOC Source: Land Survey GPS Topographic Map Other

7 WELL WATER TO BE USED AS: 1. Domestic: Household Lawn & Garden Livestock 2. Irrigation 3. Feedlot 4. Industrial 5. Public Water Supply: well ID 6. Dewatering: how many wells? 7. Aquifer Recharge: well ID 8. Monitoring: well ID 9. Environmental Remediation: well ID Air Sparge Soil Vapor Extraction Recovery Injection 10. Oil Field Water Supply: lease 11. Test Hole: well ID Cased Uncased Geotechnical 12. Geothermal: how many bores? a) Closed Loop Horizontal Vertical b) Open Loop Surface Discharge Inj. of Water 13. Other (specify):

Was a chemical/bacteriological sample submitted to KDHE? Yes No If yes, date sample was submitted: Water well disinfected? Yes No

8 TYPE OF CASING USED: Steel PVC Other CASING JOINTS: Glued Clamped Welded Threaded Casing diameter: 5 in. to 140 ft. Diameter: in. to ft. Diameter: in. to ft. Casing height above land surface: 1.7 in. Weight: 160 lbs./ft. Wall thickness or gauge No.: 260 TYPE OF SCREEN OR PERFORATION MATERIAL: Steel Stainless Steel Fiberglass PVC Other (Specify) Brass Galvanized Steel Concrete tile None used (open hole) SCREEN OR PERFORATION OPENINGS ARE: Continuous Slot Mill Slot Gauze Wrapped Torch Cut Drilled Holes Other (Specify) Louvered Shutter Key Punched Wire Wrapped Saw Cut None (Open Hole) SCREEN-PERFORATED INTERVALS: From 120 ft. to 140 ft. From ft. to ft. From ft. to ft. GRAVEL PACK INTERVALS: From 24 ft. to 140 ft. From ft. to ft. From ft. to ft.

9 GROUT MATERIAL: Neat cement Cement grout Bentonite Other Grout Intervals: From 4 ft. to 24 ft. From 24 ft. to ft. From ft. to ft. Nearest source of possible contamination: Septic Tank Lateral Lines Pit Privy Livestock Pens Insecticide Storage Sewer Lines Cess Pool Sewage Lagoon Fuel Storage Abandoned Water Well Watertight Sewer Lines Seepage Pit Feedyard Fertilizer Storage Oil Well/Gas Well Other (Specify): Direction from well? West Distance from well? 75 ft.

10 FROM	TO	LITHOLOGIC LOG	FROM	TO	LITHO. LOG (cont.) or PLUGGING INTERVALS
0	2	Top soil			
2	33	clay			
33	51	clay fine sand			
51	117	clay			
117	140	coarse sand-gravel			

Notes:

11 CONTRACTOR'S OR LANDOWNER'S CERTIFICATION: This water well was constructed, reconstructed, or plugged under my jurisdiction and was completed on (mo-day-year) 10/22/14 and this record is true to the best of my knowledge and belief. Kansas Water Well Contractor's License No. 011 This Water Well Record was completed on (mo-day-year) 11/10/15 under the business name of Chaswell Drilling