


WATER WELL RECORD Form WWC-5 KSA 82a-1212

1	LOCATION OF WATER WELL: Sedgwick	FRACTION SW 1/4 NE 1/4 NW 1/4	SECTION NUMBER 34	TOWNSHIP NUMBER T 27 S	RANGE NUMBER R 1W E/W
---	--	---	-----------------------------	----------------------------------	---------------------------------

Distance and direction from nearest town or city street address of well if located within city?
1710 S. Airport Rd. Wichita, Kansas

2	WATER WELL OWNER: KOCH INDUSTRIES	Board of Agriculture, Division of Water Resource
	RR#, ST. ADDRESS, BOX #: 1760 S. Airport Rd.	Application Number:
	CITY, STATE: Wichita, Kansas	ZIP CODE:

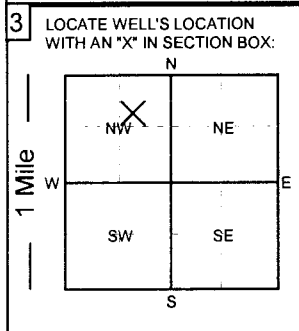

4	DEPTH OF COMPLETED WELL: 70 ft.	ELEVATION:
	Depth of groundwater Encountered:	ft.
	WELL'S STATIC WATER LEVEL 20 FT. BELOW LAND SURFACE MEASURED ON 6/1/16	mo/day/yr:
	Pump test data: Well water was	ft. after hours of pumping @
	Est. Yield: gpm	Well water was ft. after hours of pumping @
	Bore Hole Diameter 12 in.	to 70 ft. and in. to ft.
WELL WATER TO BE USED AS:		
1. Domestic 3. Feedlot 5. Public water supply <u>7. Lawn and garden only</u> 9. Dewatering 11. Injection well		
2. Irrigation 4. Industrial 6. Oil field water supply 8. Air conditioning 10. Monitoring well 12. Other (Specify below)		
Was a chemical/bacteriological sample submitted to Department? YES <u>NO</u> ; If yes, what mo/day/yr was sample submitted		
Was Water Well Disinfected? <u>YES</u> NO		

5	TYPE OF CASING USED:	5. Wrought Iron	7. Fiberglass	9. Other (Specify below)	CASING JOINTS: <u>Glued</u> Threaded
	1. Steel 3. RPM (SR)	6. Asbestos-Cement	8. Concrete tile	SDR-26	Welded Clamped
	<u>2. PVC</u> 4. ABS				
	Blank casing diameter 5 in.	to 50 ft., Dia. in.	to ft., Dia. in.	to ft.	
	Casing height above land surface: 12 in.,	Weight: 2.35 lbs. / ft.	Wall thickness or gauge No. .214		
TYPE OF SCREEN OR PERFORATION MATERIAL:					
1. Steel 3. Stainless Steel 5. Fiberglass <u>7. PVC</u> 9. ABS 11. Other (specify)					
2. Brass 4. Galvanized 6. Concrete Tile 8. RMP (SR) 10. Asbestos-Cement 12. None used (open hole)					
SCREEN OR PERFORATION OPENINGS ARE:					
1. Continuous slot 3. Mill slot 5. Gauzed wrapped <u>7. Torch cut</u> 9. Drilled holes 11. None (open hole)					
2. Louvered shutter 4. Key punched 6. Wire wrapped <u>8. Saw cut</u> 10. Other (specify)					
SCREEN - PERFORATION INTERVAL From 50 ft. to 70 ft., From ft. to ft., From ft. to ft., From ft. to ft.					
GRAVEL PACK INTERVALS: From 24 ft. to 70 ft., From ft. to ft., From ft. to ft., From ft. to ft.					

6	GROUT MATERIALS: 1. Neat cement 2. Cement Grout 3. Bentonite Other bentonite hole plug
	Grout Intervals: From 4 ft. to 24 ft., From ft. to ft., From ft. to ft.
What is the nearest source of possible contamination:	
1. Septic tank 4. Lateral lines 7. Pit privy 10. Livestock pens 13. Insecticide storage 15. Oil well/Gas well	
2. Sewer lines 5. Cess Pool 8. Sewage lagoon 11. Fuel storage 14. Abandon water well 16. Other (specify below)	
<u>3. Watertight sewer line</u> 6. Seepage pit 9. Feed yard 12. Fertilizer storage	
Direction from well? North How many feet? 10 ft. plus	

From	To	LITHOLOGIC LOG	From	To	LITHOLOGIC LOG
0	3	topsoil			
3	15	clay			
15	40	fine sand			
40	65	medium sand			
65	70	clay			

7	Contractor's or Landowner's Certification: This water well was 1. <u>constructed</u> 2. reconstructed or 3. plugged under my jurisdiction and was completed on (mo/day/year) 6/1/16 and this record is true to the best of my knowledge and belief.
	Kansas Water Well Contractor's License No. 236 This water well record was completed on (mo/day/year) 6/6/16
	under the business name of Harp Well and Pump Service by (signature) Todd S. Harp