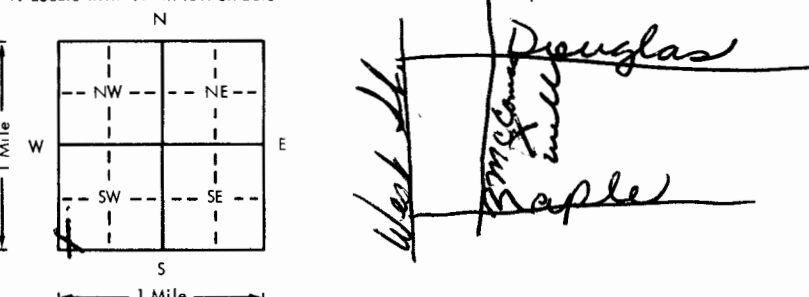


USE TYPEWRITER OR BALL
POINT PEN-PRESS FIRMLY,
PRINT CLEARLY.

WATER WELL RECORD
KSA 82a-1201-1215

Kansas Department of Health and
Environment-Division of Environment
(Water well Contractors)
Topeka, Kansas 66620

1. Location of well:		County Sedgwick	Fraction NW NE SW SW 8th 1/4 8th 1/4 8th 1/4	Section number 24	Township number 27	Range number 10	WEST
2. Distance and direction from nearest town or city: Street address of well location if in city: 124 McComas				3. Owner of well: Dary Morgan R.R. or street: 124 McComas City, state, zip code: Wichita, Kansas 6711-77			
4. Locate with "X" in section below: 				6. Bore hole dia. 8 in. Completion date Nov 1-79 Well depth 30 ft.			
5. Type and color of material				7. ☒ Cable tool ☒ Rotary ☐ Driven ☐ Dug ☐ Hollow rod ☐ Jetted ☐ Bored ☐ Reverse rotary			
				8. Use: ☒ Domestic ☐ Public supply ☐ Industry ☐ Irrigation ☐ Air conditioning ☐ Stock ☐ Lawn ☐ Oil field water ☐ Other			
				9. Casing Material: Styrene Height: above or below Threaded ☐ Welded ☐ Surface 12 in. RMP ☐ PVC ☒ Weight 120 lbs./ft. Dia. 5 in. to 30 ft. depth Wall thickness: inches or Dia. 1/4 in. to 1/4 ft. depth gage No. 1/4			
				10. Screen: Manufacturer's name Cermac Type 100 Dia. 5 Slot/gauze Slot Length 5 ft Set between 225 ft. and 30 ft. Gravel pack? No Size range of material			
				11. Static water level: 15 ft. below land surface Date Nov 1-79			
(Use a second sheet if needed)				12. Pumping level below land surfaces: ____ ft. after ____ hrs. pumping ____ g.p.m. ____ ft. after ____ hrs. pumping ____ g.p.m. Estimated maximum yield 10 g.p.m.			
				13. Water sample submitted: ____ mo./day/yr. Yes ☒ No ☐ Date ____			
				14. Well head completion: ☒ Pitless adapter ____ inches above grade			
				15. Well grouted? yes With: ☒ Neat cement ☐ Bentonite ☐ Concrete Depth: From 2 ft. to 12 ft.			
				16. Nearest source of possible contamination: ft. 50 Direction E Type SWW Well disinfected upon completion? ☒ Yes ☐ No			
(Use a second sheet if needed)				17. Pump: ☒ Not installed Manufacturer's name ____ Model number ____ HP ____ Volts ____ Length of drop pipe ____ ft. capacity ____ g.p.m. Type: ☐ Submersible ☐ Turbine ☐ Jet ☐ Reciprocating ☐ Centrifugal ☐ Other			
				18. Elevation:			
				19. Remarks:			
				20. Water well contractor's certification: This well was drilled under my jurisdiction and this report is true to the best of my knowledge and belief. Jet Drilling 3134 Business name License No. Address 257 N. Sabine Signed Walter J. Landrum Date Nov 6-79 Authorized representative			
				Topography: ☐ Hill ☐ Slope ☐ Upland ☒ Valley			

Forward the white, blue and pink copies to the Department of Health and Environment

Form WWC-5