


WATER WELL RECORD Form WWC-5 KSA 82a-1212

1 LOCATION OF WATER WELL: Sedgwick	FRACTION NW 1/4 SW 1/4 SE 1/4	SECTION NUMBER 36	TOWNSHIP NUMBER T 27 S	RANGE NUMBER R 1W EW
--	---	-----------------------------	----------------------------------	--------------------------------

Distance and direction from nearest town or city street address of well if located within city?
Just West of Meridian, North of Pawnee Wichita, Kansas (2 wells on 1 permit)

2 WATER WELL OWNER: WICHITA, CITY OF	Board of Agriculture, Division of Water Resource
RR#,ST. ADDRESS,BOX #: 455 N. Main	Application Number: 20160163
CITY, STATE: Wichita, Kansas	ZIP CODE:

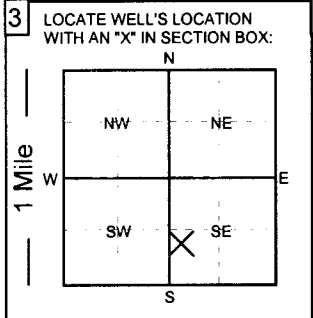

4 DEPTH OF COMPLETED WELL: 35 ft.	ELEVATION: _____ ft.
Depth of groundwater Encountered: _____ ft.	
WELL'S STATIC WATER LEVEL 14 FT. BELOW LAND SURFACE MEASURED ON 9/20/16	
Pump test data:	Well water was _____ ft. after _____ hours of pumping @ _____ gpm
Est. Yield: _____ gpm	Well water was _____ ft. after _____ hours of pumping @ _____ gpm
Bore Hole Diameter 12 in.	to 35 ft. and _____ in. to _____ ft.
WELL WATER TO BE USED AS:	
1. Domestic 3. Feedlot 5. Public water supply 7. Lawn and garden only <u>9. Dewatering</u> 11. Injection well	
2. Irrigation 4. Industrial 6. Oil field water supply 8. Air conditioning 10. Monitoring well 12. Other (Specify below)	
Was a chemical/bacteriological sample submitted to Department? YES NO ; If yes, what mo/day/yr was sample submitted _____	
Was Water Well Disinfected? <u>YES</u> NO	

5 TYPE OF CASING USED:	5. Wrought Iron	7. Fiberglass	9. Other (Specif / below)	CASING JOINTS: <u>Glued</u> Threaded
1. Steel	3. RPM (SR)			Welded Clamped
<u>2. PVC</u>	4. ABS	6. Asbestos-Cement	8. Concrete tile	SDR-26
Blank casing diameter 8 in.	to 20 ft.,	Dia. _____ in.	to _____ ft.,	Dia. _____ in. to _____ ft.
Casing height above land surface: 12 in.,	Weight: 5.52 lbs. / ft.	Wall thickness or gauge No. .332		
TYPE OF SCREEN OR PERFORATION MATERIAL:				
1. Steel	3. Stainless Steel	5. Fiberglass	<u>7. PVC</u>	9. ABS
2. Brass	4. Galvanized	6. Concrete Tile	8. RMP (SR)	10. Asbestos-Cement
11. Other (specify) _____				
12. None used (open hole)				
SCREEN OR PERFORATION OPENINGS ARE:				
1. Continuous slot	3. Mill slot	5. Gauzed wrapped	7. Torch cut	9. Drilled holes
2. Louvered shutter	4. Key punched	6. Wire wrapped	<u>8. Saw cut</u>	10. Other (specify)
11. None (open hole)				
SCREEN - PERFORATION INTERVAL				
From 20 ft.	to 30 ft.,	From _____ ft.	to _____ ft.	From _____ ft. to _____ ft.
GRAVEL PACK INTERVALS:	From 20 ft.	to 35 ft.,	From _____ ft.	to _____ ft.

6 GROUT MATERIALS:	1. Neat cement	2. Cement Grout	3. Bentonite	Other bentonite hole plug
Grout Intervals: From 0 ft.	to 20 ft.,	From _____ ft.	to _____ ft.,	From _____ ft. to _____ ft.
What is the nearest source of possible contamination:				
1. Septic tank	4. Lateral lines	7. Pit privy	10. Livestock pens	13. Insecticide storage
2. Sewer lines	5. Cess Pool	8. Sewage lagoon	11. Fuel storage	14. Abandon water well
3. Watertight sewer line	6. Seepage pit	9. Feed yard	12. Fertilizer storage	15. Oil well/Gas well
				16. Other (specify below) None Apparent
Direction from well?				How many feet? _____

From	To	LITHOLOGIC LOG	From	To	LITHOLOGIC LOG
0	3	topsoil			
3	11	clay			
11	21	fine sand			
21	35	medium sand			

7 Contractor's or Landowner's Certification: This water well was 1. <u>constructed</u> 2. reconstructed or 3. plugged under my jurisdiction and was completed on (mo/day/year) 9/20/2016 and this record is true to the best of my knowledge and belief.	How many feet? _____
Kansas Water Well Contractor's License No. 236	This water well record was completed on (mo/day/year) 9/23/2016
under the business name of Harp Well and Pump Service	by (signature) <i>Todd S. Harp</i>