aka DBMW-2

TW 2-88

WATER WELL PLUGGING RECORD Form WWC-5P KSA 82a-1212 ID NO.

1 LOCATION OF WATER WELL: County: Sedgwick	Fraction: NW ¼ SE ¼ SW ¼ SW ¼	Section Number: 36	Township Number: 27 T S	Range Number: 1 ☐ E ☑ W

Street/Rural Address of Well Location; if unknown, distance & direction from nearest town or intersection: If at owner's address, check here ☐ 3720 W. Pawnee, Wichita

Global Positioning Systems (GPS) information:
Latitude: 37.652319 (in decimal degrees)
Longitude: 97.386686 (in decimal degrees)
Elevation: _____
Horizontal Datum: ☑ WGS84, ☐ NAD83, ☐ NAD27
Collection Method:
☐ GPS unit (Make/Model: _____)
☑ Digital Map/Photo, ☐ Topographic Map, ☐ Land Survey
Est. Accuracy: ☑ < 3 m, ☐ 3-5 m, ☐ 5-15 m, ☐ > 15 m

2 WATER WELL OWNER: Dawson Brothers, Inc.
RR#, St. Address, Box #: 3800 W. Pawnee
City, State ZIP Code: Wichita, KS 67213

3 MARK WELL'S LOCATION WITH AN "X" IN SECTION BOX:

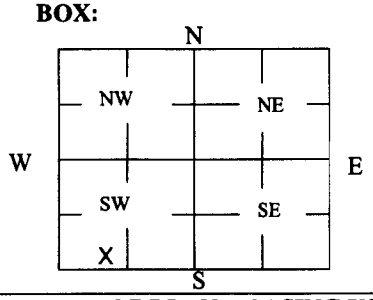

4 DEPTH OF WELL 47.71 ft.
WELL'S STATIC WATER LEVEL 12.22 ft
WELL WAS USED AS:

☐ Domestic	☐ Public Water Supply	☐ Dewatering
☐ Irrigation	☐ Oil Field Water Supply	☑ Monitoring
☐ Feedlot	☐ Domestic (Lawn & Garden)	☐ Injection Well
☐ Industrial	☐ Air Conditioning	☐ Other _____

Was a chemical/bacteriological sample submitted to Department? Yes ☐ No ☑

5 TYPE OF BLANK CASING USED:

☐ Steel	☐ RMP (SR)	☐ Wrought	☐ Fiberglass	☐ Other (Specify below)
☑ PVC	☐ ABS	☐ Asbestos-Cement	☐ Concrete Tile	_____

Blank casing diameter 2 in. Was casing pulled? Yes ☑ No ☐ If yes, how much 3 ft.
Casing height above or below land surface 36 in.

6 GROUT PLUG MATERIAL: ☐ Neat cement ☐ Cement grout ☑ Bentonite ☐ Other _____

Grout Plug Intervals: From 3 ft. to 47.71 ft., From _____ ft. to _____ ft., From _____ ft. to _____ ft.

What is the nearest source of possible contamination:

☐ Septic tank	☐ Seepage pit	☐ Fuel storage	☐ Other (specify below)
☐ Sewer lines	☐ Pit privy	☐ Fertilizer storage	_____
☐ Watertight sewer lines	☐ Sewage lagoon	☐ Insecticide storage	
☐ Lateral lines	☐ Feedyard	☐ Abandoned water well	Direction from well? _____
☐ Cess pool	☐ Livestock pens	☐ Oil well/Gas well	How many feet? _____

FROM	TO	PLUGGING MATERIALS	FROM	TO	PLUGGING MATERIALS
0	0.5	Native soil			
0.5	3	Clay			
3	47.71	Bentonite chips			

7 CONTRACTOR'S OR LANDOWNER'S CERTIFICATION: This water well was plugged under my jurisdiction and was completed on (mo/day/year) 07/18/2016 and this record is true to the best of my knowledge and belief. Kansas Water Well Contractor's License No. 531. This Water Well Record was completed on (mo/day/year) 07/22/2016 under the business name of GSI Engineering, LLC by (signature) _____

Send one white copy to Kansas Department of Health & Environment, Geology Section, 1000 SW Jackson Street, Ste. 420, Topeka, KS 66612-1367. Send one copy to WATER WELL OWNER and retain one for your records.
Visit us at http://www.kdheks.gov/waterwell/index.html Telephone 785-296-5524.

KSA82a-1212 **Revised 1/20/2015**