


**WATER WELL RECORD Form WWC-5 KSA 82a-1212**

1 LOCATION OF WATER WELL: <b>Sedgwick</b>	FRACTION <b>SE 1/4 NW 1/4 NW 1/4</b>	SECTION NUMBER <b>2</b>	TOWNSHIP NUMBER <b>T 27 S</b>	RANGE NUMBER <b>R 1W E/W</b>
--	---	----------------------------	----------------------------------	---------------------------------

Distance and direction from nearest town or city street address of well if located within city?  
**2932 N. Curtis Wichita, Kansas**

2 WATER WELL OWNER: <b>SHARP HOMES</b>	Board of Agriculture, Division of Water Resource
RR#,ST. ADDRESS,BOX #: CITY, STATE:	<b>2131 N. Collective Ste. #A</b> <b>Wichita, Kansas</b>
	ZIP CODE: <b>67206</b> Application Number:

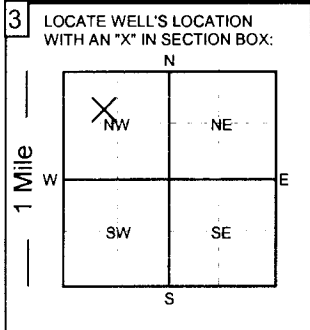

4 DEPTH OF COMPLETED WELL: <b>37</b> ft.	ELEVATION:
Depth of groundwater Encountered: _____ ft.	_____ ft.
WELL'S STATIC WATER LEVEL <b>10</b> FT. BELOW LAND SURFACE MEASURED ON <b>10/30/17</b>	
Pump test data: Well water was _____ ft. after _____ hours of pumping @ _____ gpm	
Est. Yield: gpm Well water was _____ ft. after _____ hours of pumping @ _____ gpm	
Bore Hole Diameter <b>12</b> in. to <b>37</b> ft. and _____ in. to _____ ft.	
WELL WATER TO BE USED AS:	
1. Domestic 3. Feedlot 5. Public water supply <b>7. Lawn and garden only</b> 9. Dewatering 11. Injection well	12. Other (Specify below)
2. Irrigation 4. Industrial 6. Oil field water supply 8. Air conditioning 10. Monitoring well	
Was a chemical/bacteriological sample submitted to Department? <b>YES</b> <b>NO</b> ; If yes, what mo/day/yr was sample submitted	
Was Water Well Disinfected? <b>YES</b> <b>NO</b>	

5 TYPE OF CASING USED:		5. Wrought Iron	7. Fiberglass	9. Other (Specify below)	CASING JOINTS:	<b>Glued</b>	Threaded	
1. Steel	3. RPM (SR)	6. Asbestos-Cement	8. Concrete tile	SDR-26	Welded	Clamped		
<b>2. PVC</b>	4. ABS							
Blank casing diameter	<b>5</b> in. to <b>25</b> ft., Dia.	in.	to	ft., Dia.	in.	to	ft.	
Casing height above land surface:	<b>12</b> in.,	Weight:	<b>2.35</b> lbs. / ft.	Wall thickness or gauge No.	<b>.214</b>			
TYPE OF SCREEN OR PERFORATION MATERIAL:								
1. Steel	3. Stainless Steel	5. Fiberglass	<b>7. PVC</b>	9. ABS	11. Other (specify)			
2. Brass	4. Galvanized	6. Concrete Tile	8. RMP (SR)	10. Asbestos-Cement	12. None used (open hole)			
SCREEN OR PERFORATION OPENINGS ARE:								
1. Continuous slot	3. Mill slot	5. Gauzed wrapped	7. Torch cut	9. Drilled holes	11. None (open hole)			
2. Louvered shutter	4. Key punched	6. Wire wrapped	<b>8. Saw cut</b>	10. Other (specify)				
SCREEN - PERFORATION INTERVAL	From	<b>25</b> ft.	to	<b>32</b> ft.,	From	ft.	to	ft.
	From	ft.	to	ft.,	From	ft.	to	ft.
GRAVEL PACK INTERVALS:	From	<b>24</b> ft.	to	<b>37</b> ft.,	From	ft.	to	ft.
	From	ft.	to	ft.,	From	ft.	to	ft.

6 GROUT MATERIALS:		1. Neat cement	2. Cement Grout	3. Bentonite	Other <b>bentonite hole plug</b>
Grout Intervals:	From <b>4</b> ft. to <b>24</b> ft.,	From	ft.	to	ft., From ft. to ft.
What is the nearest source of possible contamination:					
1. Septic tank	4. Lateral lines	7. Pit privy	10. Livestock pens	13. Insecticide storage	15. Oil well/Gas well
2. Sewer lines	5. Cess Pool	8. Sewage lagoon	11. Fuel storage	14. Abandon water well	16. Other (specify below)
<b>3. Watertight sewer line</b>	6. Seepage pit	9. Feed yard	12. Fertilizer storage		
Direction from well? <b>West</b>					How many feet? <b>60 ft. plus</b>

From	To	LITHOLOGIC LOG	From	To	LITHOLOGIC LOG
<b>0</b>	<b>3</b>	<b>topsoil</b>			
<b>3</b>	<b>11</b>	<b>fine sand (clay)</b>			
<b>11</b>	<b>25</b>	<b>fine sand</b>			
<b>25</b>	<b>37</b>	<b>medium sand</b>			

7 Contractor's or Landowner's Certification: This water well was 1. <b>constructed</b> 2. reconstructed or 3. plugged under my jurisdiction and was completed on (mo/day/year) <b>10/30/2017</b> and this record is true to the best of my knowledge and belief.	
Kansas Water Well Contractor's License No. <b>236</b>	This water well record was completed on (mo/day/year) <b>11/3/17</b>
under the business name of <b>Harp Well and Pump Service</b>	by (signature) <b>Todd S. Harp</b>