


WATER WELL RECORD Form WWC-5 KSA 82a-1212

1 LOCATION OF WATER WELL: Sedgwick	FRACTION SW 1/4 SE 1/4 NE 1/4	SECTION NUMBER 5	TOWNSHIP NUMBER T 27 S	RANGE NUMBER R 1W E/W
---	---	----------------------------	----------------------------------	---------------------------------

Distance and direction from nearest town or city street address of well if located within city?
9002 W. Central Park Wichita, Kansas

2 WATER WELL OWNER: ZORN, Michael	Board of Agriculture, Division of Water Resource
RR#,ST. ADDRESS,BOX #: 9002 W. Central Park	Application Number:
CITY, STATE: Wichita, Kansas	ZIP CODE:

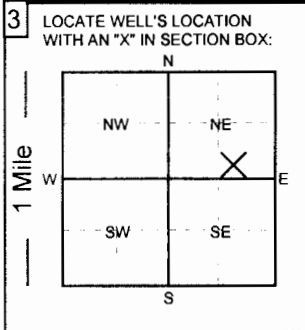

4 DEPTH OF COMPLETED WELL: 70 ft.	ELEVATION:	ft.
Depth of groundwater Encountered: ft.		
WELL'S STATIC WATER LEVEL: 25 FT. BELOW LAND SURFACE MEASURED ON	mo/day/yr: 10/11/17	
Pump test data: Well water was	ft. after	hours of pumping @
gpm	ft. after	gpm
Est. Yield: gpm	Well water was	hours of pumping @
gpm	ft. after	gpm
Bore Hole Diameter: 12 in.	to 70 ft.	and in. to ft.
WELL WATER TO BE USED AS:		
1. Domestic	3. Feedlot	5. Public water supply
2. Irrigation	4. Industrial	6. Oil field water supply
7. Lawn and garden only	9. Dewatering	11. Injection well
8. Air conditioning	10. Monitoring well	12. Other (Specify below)
Was a chemical/bacteriological sample submitted to Department? YES NO ; If yes, what mo/day/yr was sample submitted		
Was Water Well Disinfected? YES NO		

5 TYPE OF CASING USED:	5. Wrought Iron	7. Fiberglass	9. Other (Specify below)	CASING JOINTS:
1. Steel	3. RPM (SR)	6. Asbestos-Cement	8. Concrete tile	Glued Threaded
2. PVC	4. ABS		SDR-26	Welded Clamped
Blank casing diameter: 5 in.	to 50 ft., Dia.	in.	to ft.	Dia. in. to ft.
Casing height above land surface: 12 in.,	Weight: 2.35 lbs. / ft.	Wall thickness or gauge No. .214		
TYPE OF SCREEN OR PERFORATION MATERIAL:				
1. Steel	3. Stainless Steel	5. Fiberglass	7. PVC	9. ABS
2. Brass	4. Galvanized	6. Concrete Tile	8. RMP (SR)	10. Asbestos-Cement
11. Other (specify)	12. None used (open hole)			
SCREEN OR PERFORATION OPENINGS ARE:				
1. Continuous slot	3. Mill slot	5. Gauzed wrapped	7. Torch cut	9. Drilled holes
2. Louvered shutter	4. Key punched	6. Wire wrapped	8. Saw cut	10. Other (specify)
11. None (open hole)				
SCREEN - PERFORATION INTERVAL	From 50 ft.	to 70 ft.,	From ft.	to ft.
GRAVEL PACK INTERVALS:	From 24 ft.	to 70 ft.,	From ft.	to ft.

6 GROUT MATERIALS:	1. Neat cement	2. Cement Grout	3. Bentonite	Other
Grout Intervals: From 4 ft.	to 24 ft.,	From ft.	to ft.	From ft. to ft.
What is the nearest source of possible contamination:				
1. Septic tank	4. Lateral lines	7. Pit privy	10. Livestock pens	13. Insecticide storage
2. Sewer lines	5. Cess Pool	8. Sewage lagoon	11. Fuel storage	14. Abandon water well
3. Watertight sewer line	6. Seepage pit	9. Feed yard	12. Fertilizer storage	15. Oil well/Gas well
Direction from well? North				16. Other (specify below)
				How many feet? 50 ft. plus

From	To	LITHOLOGIC LOG	From	To	LITHOLOGIC LOG
0	3	topsoil			
3	22	clay			
22	50	fine sand			
50	70	medium sand			

7 Contractor's or Landowner's Certification: This water well was **1. constructed** 2. reconstructed or 3. plugged under my jurisdiction and was completed on (mo/day/year) **10/11/17** and this record is true to the best of my knowledge and belief.

Kansas Water Well Contractor's License No. **236** This water well record was completed on (mo/day/year) **10/13/17**

under the business name of **Harp Well and Pump Service** by (signature) **Todd S. Harp**