


WATER WELL RECORD Form WWC-5 KSA 82a-1212

1 LOCATION OF WATER WELL: Sedgwick FRACTION: SE 1/4 NW 1/4 NW 1/4 SECTION NUMBER: 34 TOWNSHIP NUMBER: T 27 S RANGE NUMBER: R 1W E/W

Distance and direction from nearest town or city street address of well if located within city? 1780 S. Airport Rd. Wichita, Kansas

2 WATER WELL OWNER: YINGLING AIRCRAFT Board of Agriculture, Division of Water Resource RR#,ST. ADDRESS,BOX #: 1780 S. Airport Rd. CITY, STATE: Wichita, Kansas ZIP CODE: Application Number:

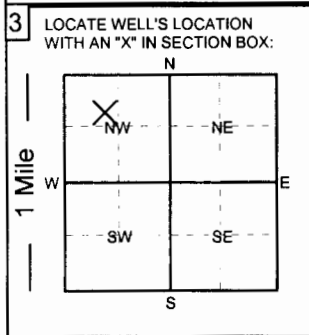

3 LOCATE WELL'S LOCATION WITH AN "X" IN SECTION BOX: 4 DEPTH OF PLUGGED WELL: 40 ft. ELEVATION: Depth of groundwater Encountered: WELL'S STATIC WATER LEVEL 16 FT. BELOW LAND SURFACE MEASURED ON 9/18/17

5 TYPE OF CASING USED: 1. Steel 3. RPM (SR) 5. Wrought Iron 7. Fiberglass 9. Other (Specify below) CASING JOINTS: Glued Threaded 2. PVC 4. ABS 6. Asbestos-Cement 8. Concrete tile Welded Clamped

6 GROUT MATERIALS: 1. Neat cement 2. Cement Grout 3. Bentonite Other bentonite hole plug Grout Intervals: From ft. to ft., From ft. to ft., From ft. to ft.

LITHOLOGIC LOG table with columns for From, To, and description. Entries include compacted topsoil (0-6 ft) and bentonite hole plug (6-40 ft).

7 Contractor's or Landowner's Certification: This water well was 1. constructed 2. reconstructed or 3. plugged under my jurisdiction and was completed on (mo/day/year) 9/18/17 and this record is true to the best of my knowledge and belief.