

WATER WELL RECORD

Form WWC-5

Division of Water Resources App. No.

[Empty box for App. No.]


Well ID

MW51

- Original Record, Correction, Change in Well Ust

1 LOCATION OF WATER WELL: County Sedgwick, Fraction 1/4 NE 1/4 SW 1/4 NW 1/4, Section Number 29, Township Number T 27 S, Range Number R 1 E X W

2 WELL OWNER: Last Name: Business: Miller's Cleaners, Address: 323 S Maize Rd., City: Wichita, State: KS, ZIP: [Empty], Street or Rural Address where well is located: ~1,700' SE of 323 S Maize Rd., Wichita KS

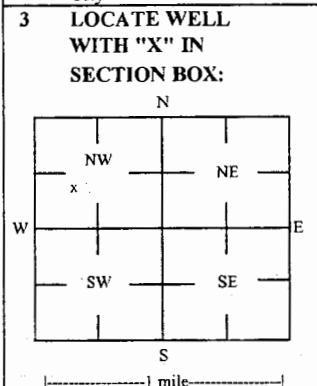

4 DEPTH OF COMPLETED WELL: 60 ft, Depth(s) Groundwater Encountered: 1) [Empty] ft, 2) [Empty] ft, 3) [Empty] ft, or 4) [] Dry Well, WELL'S STATIC WATER LEVEL: NA ft, [X] below land surface, measured on (mo-day-yr) NA, [] above land surface, measured on (mo-day-yr) [Empty], Pump test data: Well water was [Empty] ft after [Empty] hours pumping [Empty] gpm, Water well was [Empty] ft after [Empty] hours pumping [Empty] gpm, Estimated Yield: [Empty] gpm, Bore Hole Diameter: 8.25 in to [Empty] ft, and [Empty] in to [Empty] ft

5 Latitude: 37.674536 (decimal degrees), Longitude: -97.459358 (decimal degrees), Horizontal Datum: [] WGS 84 [] NAD 83 [] NAD 27, Source for Latitude/Longitude: [X] GPS (unit make/model: [Empty]), (WAAS enabled? [] Yes [] No), [] Land Survey [] Topographic Map, [] Online Mapper

6 Elevation [Empty] ft, [] Ground Level [] TOC, Source [] Land Survey [] GPS [] Topographic Map, [] Other [Empty]

7 WELL WATER TO BE USED AS: 1 Domestic: [] Household, [] Lawn & Garden, [] Livestock, 2 [] Irrigation, 3 [] Feedlot, 4 [] Industrial, 5 [] Public Water Supply: well ID [Empty], 6 [] Dewatering: how many wells? [Empty], 7 [] Aquifer Recharge: well ID [Empty], 8 [X] Monitoring: well ID MW51, 9 Environmental Remediation: well ID [Empty], [] Air Sparge, [] Soil Vapor Extractor, [] Recovery, [] Injection, 10 [] Oil Field Water Supply: lease [Empty], 11 Test Hole: well ID [Empty], [] Cased, [] Uncased, [] Geotechnical, 12 Geothermal: How many bores? [Empty], a) Closed Loop [] Horizontal [] Vertical, b) Open Loop [] Surface Discharge [] Inj. of Water, [] Other (specify): [Empty]

Was a chemical/bacteriological sample submitted to KDHE? [] Yes [X] No, If yes, date sample was submitted: [Empty], Water well disinfected? [] Yes [X] No

8 TYPE OF CASING USED: [] Steel [X] PVC [] Other [Empty], CASING JOINTS: [] Glued [] Clamped [] Welded [X] Threaded, Casing diameter 2 in. to 40 ft, Diameter [Empty] in. to [Empty] ft, Diameter [Empty] in. to [Empty] ft, Casing height above land surface 0 in., Weight [Empty] lbs./ft., Well thickness or gauge No [Empty], TYPE OF SCREEN OR PERFORATION MATERIAL: [] Steel [] Stainless Steel [] Fiberglass [X] PVC [] Other (Specify) [Empty], [] Brass [] Galvanized Steel [] Concrete tile [] None used (open hole), SCREEN OR PERFORATION OPENINGS ARE: [] Continuous Slot [X] Mill Slot [] Gauze Wrapped [] Torch Cut [] Drilled Holes [] Other (Specify) [Empty], [] Louvered Shutter [] Key Punched [] Wire Wrapped [] Saw Cut [] None (Open Hole), SCREEN-PERFORATED INTERVALS: From 40 ft. to 60 ft., From [Empty] ft. to [Empty] ft., From [Empty] ft. to [Empty] ft., GRAVEL PACK INTERVALS: From 38 ft. to 60 ft., From [Empty] ft. to [Empty] ft., From [Empty] ft. to [Empty] ft.

9 GROUT MATERIAL: [] Neat cement [] Cement grout [X] Bentonite [X] Other Concrete: 0-0.5', Grout intervals: From 0.5 ft. to 38 ft., From [Empty] ft. to [Empty] ft., From [Empty] ft. to [Empty] ft.

Nearest source of possible contamination: [] Septic Tank, [] Lateral Lines, [] Pit Privy, [] Livestock Pens, [] Insecticide Storage, [] Sewer Lines, [] Cess Pool, [] Sewage Lagoon, [] Fuel Storage, [] Abandoned Water Well, [] Watertight Sewer Lines, [] Seepage Pit, [] Feedyard, [] Fertilizer Storage, [] Oil Well / Gas Well, [] Other (Specify) [Empty], Direction from well? [Empty], Distance from well? [Empty] ft

Table with columns: FROM, TO, LITHOLOGIC LOG, FROM, TO, LITHO. LOG (cont.) or PLUGGING INTERVALS. Rows: 0-0.3 Topsoil, 0.3-10 Silty clay, 10-25 Silty clay w/ fine sand, 25-45 Clayey silt w/ fine-medium sand, 45-60 Silt w/ fine-coarse sand

Notes: KDHE ID: Miller's Cleaners; C2-087-73383, Target of monitoring well is shallow groundwater, <20' of grout was installed at the direction of KDHE.

11 CONTRACTOR'S OR LANDOWNER'S CERTIFICATION: This water well was [X] constructed, [] reconstructed, or [] plugged under my jurisdiction and was completed on (mo-day-year) 12/21/17 and this record is true to the best of my knowledge and belief. Kansas Water Well Contractor's License No 757 This Water Well Record was completed on (mo-day-year) 2/1/18 under the business name of Larsen & Associates, Inc. Signature [Signature]