

WATER WELL RECORD

Form WWC-5

Division of Water Resources App. No.


Well ID

MW9D

Original Record Correction Change in Well Ust

1 LOCATION OF WATER WELL: County Sedgwick Fraction 1/4 SE 1/4 NW 1/4 SW 1/4 Section Number 29 Township Number T 27 S Range Number R 1 E X W

2 WELL OWNER: Last Name: Business: Miller's Cleaners Address: 323 S Maize Rd. City: Wichita State: KS ZIP: Street or Rural Address where well is located (if unknown, distance and direction from nearest town or intersection): ~3,600' SE of 323 S Maize Rd., Wichita KS

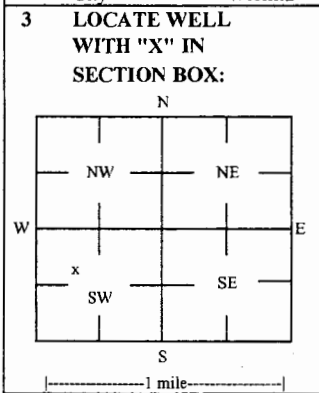

3 LOCATE WELL WITH 'X' IN SECTION BOX: 4 DEPTH OF COMPLETED WELL: 90 ft Depth(s) Groundwater Encountered: 1) 90 ft 2) ... 3) ... 4) Dry Well WELL'S STATIC WATER LEVEL: NA ft. X below land surface, measured on (mo-day-yr) NA

5 Latitude: 37.669632 (decimal degrees) Longitude: -97.458307 (decimal degrees) Horizontal Datum: WGS 84 NAD 83 NAD 27 Source for Latitude/Longitude: GPS (unit make/model: ) (WAAS enabled? Yes No) Land Survey Topographic Map Online Mapper

6 Elevation: ft Ground Level TOC Source: Land Survey GPS Topographic Map Other

7 WELL WATER TO BE USED AS: 1 Domestic: Household Lawn & Garden Livestock Irrigation Feedlot Industrial 2 Public Water Supply: well ID 3 Dewatering: how many wells? 4 Aquifer Recharge: well ID 5 Monitoring: well ID MW9D 6 Environmental Remediation: well ID Air Sparge Soil Vapor Extractor Recovery Injection 7 Oil Field Water Supply: lease 8 Test Hole: well ID Cased Uncased Geotechnical 9 Geothermal: How many bores? a) Closed Loop Horizontal Vertical b) Open Loop Surface Discharge Inj. of Water Other (specify):

Was a chemical/bacteriological sample submitted to KDHE? Yes No X No If yes, date sample was submitted: Water well disinfected? Yes No X No

8 TYPE OF CASING USED: Steel PVC Other CASING JOINTS: Glued Clamped Welded X Threaded Casing diameter 2 in. to 70 ft, Diameter in. to ft, Diameter in. to ft, Casing height above land surface 3 in. Weight lbs./ft. Well thickness or gauge No TYPE OF SCREEN OR PERFORATION MATERIAL: Steel Stainless Steel Fiberglass PVC Other (Specify) SCREEN OR PERFORATION OPENINGS ARE: Continuous Slot X Mill Slot Gauze Wrapped Torch Cut Drilled Holes Other (Specify) Louvered Shutter Key Punched Wire Wrapped Saw Cut None (Open Hole) SCREEN-PERFORATED INTERVALS: From 70 ft. to 90 ft. GRAVEL PACK INTERVALS: From 68 ft. to 90 ft.

9 GROUT MATERIAL: Neat cement Cement grout X Bentonite X Other Concrete: 0-0.5' Grout intervals: From 0.5 ft. to 68 ft.

Nearest source of possible contamination: Septic Tank Lateral Lines Pit Privy Livestock Pens Insecticide Storage Sewer Lines Cess Pool Sewage Lagoon Fuel Storage Abandoned Water Well Watertight Sewer Lines Seepage Pit Feedyard Fertilizer Storage Oil Well / Gas Well Other (Specify) Direction from well? Distance from well? ft

Table with columns: FROM, TO, LITHOLOGIC LOG, FROM, TO, LITHO. LOG (cont.) or PLUGGING INTERVALS. Rows include Topsoil, Silty clay, Clayey silt w/ fine sand, Clayey silt w/ fine-medium sand, Silt w/ fine-coarse sand, Silt w/ fine-medium sand, Fine-coarse sand.

Notes: KDHE ID: Miller's Cleaners; C2-087-73383 Target of monitoring well is shallow groundwater, <20' of grout was installed at the direction of KDHE.

11 CONTRACTOR'S OR LANDOWNER'S CERTIFICATION: This water well was X constructed, reconstructed, or plugged under my jurisdiction and was completed on (mo-day-year) 1/26/18 and this record is true to the best of my knowledge and belief. Kansas Water Well Contractor's License No 757 This Water Well Record was completed on (mo-day-year) 2/1/18 under the business name of Larsen & Associates, Inc. Signature