

County: Sedgwick Fraction: NW SW NE NW Sec. 6 T. 27 S R. 1 E/W

**CORRECTION(S) to WATER WELL COMPLETION RECORD Form WWC-5 (to rectify lacking or incorrect information)**

Owner: Dorsey Burgess

If location corrected, was listed as:

Location changed to:

Section-Township-Range: \_\_\_\_\_

Fraction (1/4 calls): \_\_\_\_\_

Other changes: Initial statements: Casing Height NOT 1'

Changed to: Casing Height IS 18'

RECEIVED

OCT 12 2018

Comments: \_\_\_\_\_

BUREAU OF WATER

Verification method: \_\_\_\_\_

Marsena Bulger

Initials: MBN Date: 10-8-18

Submitted by:  Kansas Geological Survey, Data Resources Library, 1930 Constant Ave., Lawrence, KS 66047-3726

Kansas Dept. of Health & Environment, Bureau of Water, 1000 SW Jackson, Suite 420, Topeka, KS 66612-1367


WATER WELL RECORD Form WWC-5

Division of Water Resources App. No. [ ] Well ID [ ]

Original Record  Correction  Change in Well Use

1 LOCATION OF WATER WELL: County: Sedgwick Fraction NW 1/4 SW 1/4 NE 1/4 NW 1/4 Section Number 6 Township Number T 27 S Range Number R 1  E  W

2 WELL OWNER: Last Name BURGESS First DORSEY Street or Rural Address where well is located (if unknown, distance and direction from nearest town or intersection): If at owner's address, check here:  Business Address: 11549 W Ryan Circle Address: City: Wichita State: Kansas ZIP: 67205

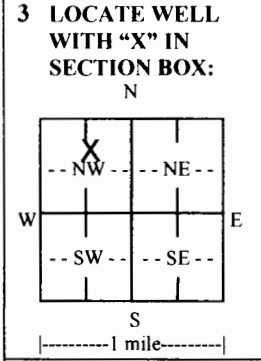

4 DEPTH OF COMPLETED WELL: 60 ft. Depth(s) Groundwater Encountered: 1) 18 ft. 2) ... ft. 3) ... ft. or 4)  Dry Well WELL'S STATIC WATER LEVEL: 18 ft.  below land surface, measured on (mo-day-yr) 8/1/2018  above land surface, measured on (mo-day-yr) Pump test data: Well water was ... ft. after ... hours pumping ... gpm Well water was ... ft. after ... hours pumping ... gpm Estimated Yield: 18 gpm Bore Hole Diameter: 11 in. to 60 ft. and ... in. to ... ft.

5 Latitude: 37.734169 (decimal degrees) Longitude: 97.476108 (decimal degrees) Datum:  WGS 84  NAD 83  NAD 27 Source for Latitude/Longitude:  GPS (unit make/model: ...) (WAAS enabled?  Yes  No)  Land Survey  Topographic Map  Online Mapper:

6 Elevation: 1362 ft.  Ground Level  TOC Source:  Land Survey  GPS  Topographic Map  Other KOLAR

7 WELL WATER TO BE USED AS: 1. Domestic:  Household  Lawn & Garden  Livestock 2.  Irrigation 3.  Feedlot 4.  Industrial 5.  Public Water Supply: well ID 6.  Dewatering: how many wells? 7.  Aquifer Recharge: well ID 8.  Monitoring: well ID 9. Environmental Remediation: well ID  Air Sparge  Soil Vapor Extraction  Recovery  Injection 10.  Oil Field Water Supply: lease 11. Test Hole: well ID  Cased  Uncased  Geotechnical 12. Geothermal: how many bores? a) Closed Loop  Horizontal  Vertical b) Open Loop  Surface Discharge  Inj. of Water 13.  Other (specify):

Was a chemical/bacteriological sample submitted to KDHE?  Yes  No If yes, date sample was submitted: Water well disinfected?  Yes  No

8 TYPE OF CASING USED:  Steel  PVC  Other CASING JOINTS:  Glued  Clamped  Welded  Threaded Casing diameter 5 in. to 60 ft. Diameter in. to ... ft. Diameter in. to ... ft. Casing height above land surface 12 in. Weight lbs./ft. Wall thickness or gauge No. 0.214

TYPE OF SCREEN OR PERFORATION MATERIAL:  Steel  Stainless Steel  Fiberglass  PVC  Other (Specify)  Brass  Galvanized Steel  Concrete tile  None used (open hole) SCREEN OR PERFORATION OPENINGS ARE:  Continuous Slot  Mill Slot  Gauze Wrapped  Torch Cut  Drilled Holes  Other (Specify)  Louvered Shutter  Key Punched  Wire Wrapped  Saw Cut  None (Open Hole) SCREEN-PERFORATED INTERVALS: From 40 ft. to 60 ft., From ... ft. to ... ft., From ... ft. to ... ft. GRAVEL PACK INTERVALS: From 21 ft. to 60 ft., From ... ft. to ... ft., From ... ft. to ... ft.

9 GROUT MATERIAL:  Neat cement  Cement grout  Bentonite  Other Grout Intervals: From 1 ft. to 21 ft., From ... ft. to ... ft., From ... ft. to ... ft., From ... ft. to ... ft.

Nearest source of possible contamination:  Septic Tank  Lateral Lines  Pit Privy  Livestock Pens  Insecticide Storage  Sewer Lines  Cess Pool  Sewage Lagoon  Fuel Storage  Abandoned Water Well  Watertight Sewer Lines  Seepage Pit  Feedyard  Fertilizer Storage  Oil Well/Gas Well  Other (Specify) Direction from well? South Distance from well? 100 ft.

10 FROM	TO	LITHOLOGIC LOG	FROM	TO	LITHO. LOG (cont.) or PLUGGING INTERVALS
0	8	Topsoil			
8	17	Brown Clay			
17	25	Silty Brown Clay			
25	40	Fine/Medium Sand			
40	55	Medium Sand			
55	60	Medium Sand with Clay Layers			
Notes:					

11 CONTRACTOR'S OR LANDOWNER'S CERTIFICATION: This water well was  constructed,  reconstructed, or  plugged under my jurisdiction and was completed on (mo-day-year) 8/1/2018 and this record is true to the best of my knowledge and belief. Kansas Water Well Contractor's License No. 238 This Water Well Record was completed on (mo-day-year) 8/2/2018 under the business name of Premier Pump and Well Service, Inc.

1417292