


WATER WELL RECORD Form WWC-5 KSA 82a-1212

1 LOCATION OF WATER WELL: Sedgwick	FRACTION NW 1/4 NE 1/4 NW 1/4	SECTION NUMBER 2	TOWNSHIP NUMBER T 27 S	RANGE NUMBER R 1W E/W
--	---	----------------------------	----------------------------------	---------------------------------

Distance and direction from nearest town or city street address of well if located within city?
5019 W. Wave Crest Circle Wichita, Kansas

2 WATER WELL OWNER: BOHN, Jerry	Board of Agriculture, Division of Water Resource
RR#,ST. ADDRESS,BOX #: 5019 W. Wave Crest Circle	Application Number:
CITY, STATE: Wichita, Kansas	ZIP CODE:

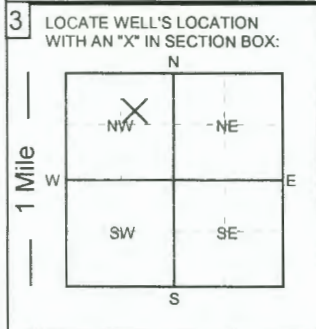

4 DEPTH OF COMPLETED WELL: 35 ft.	ELEVATION:
Depth of groundwater Encountered:	ft.
WELL'S STATIC WATER LEVEL 10 FT. BELOW LAND SURFACE MEASURED ON 7/13/18	mo/day/yr:
Pump test data:	ft. after
Est. Yield: gpm	Well water was
Well water was	hours of pumping @
ft. after	gpm
hours of pumping @	gpm
Bore Hole Diameter 12 in.	to 35 ft.
and	in.
to	ft.
WELL WATER TO BE USED AS:	
1. Domestic	3. Feedlot
5. Public water supply	7. Lawn and garden only
9. Dewatering	11. Injection well
2. Irrigation	4. Industrial
6. Oil field water supply	8. Air conditioning
10. Monitoring well	12. Other (Specify below)
Was a chemical/bacteriological sample submitted to Department? YES NO	
If yes, what mo/day/yr was sample submitted	
Was Water Well Disinfected? YES NO	

5 TYPE OF CASING USED:	1. Steel	3. RPM (SR)	5. Wrought Iron	7. Fiberglass	9. Other (Specify below)	CASING JOINTS:	Glued	Threaded		
2. PVC	4. ABS	6. Asbestos-Cement	8. Concrete tile	SDR-26		Welded	Clamped			
Blank casing diameter	5 in.	to 25 ft.,	Dia.	in.	to	ft.,	Dia.	in.	to	ft.
Casing height above land surface:	12 in.,	Weight:	2.35 lbs. / ft.	Wall thickness or gauge No.	.214					
TYPE OF SCREEN OR PERFORATION MATERIAL:										
1. Steel	3. Stainless Steel	5. Fiberglass	7. PVC	9. ABS	11. Other (specify)					
2. Brass	4. Galvanized	6. Concrete Tile	8. RMP (SR)	10. Asbestos-Cement	12. None used (open hole)					
SCREEN OR PERFORATION OPENINGS ARE:										
1. Continuous slot	3. Mill slot	5. Gauzed wrapped	7. Torch cut	9. Drilled holes	11. None (open hole)					
2. Louvered shutter	4. Key punched	6. Wire wrapped	8. Saw cut	10. Other (specify)						
SCREEN - PERFORATION INTERVAL	From	25 ft.	to	35 ft.,	From	ft.	to	ft.		
	From	ft.	to	ft.,	From	ft.	to	ft.		
GRAVEL PACK INTERVALS:	From	24 ft.	to	35 ft.,	From	ft.	to	ft.		
	From	ft.	to	ft.,	From	ft.	to	ft.		

6 GROUT MATERIALS:	1. Neat cement	2. Cement Grout	3. Bentonite	Other	bentonite hole plug
Grout Intervals:	From 4 ft.	to 24 ft.,	From	ft.	to
From	ft.	to	ft.,	From	ft.
What is the nearest source of possible contamination:					
1. Septic tank	4. Lateral lines	7. Pit privy	10. Livestock pens	13. Insecticide storage	15. Oil well/Gas well
2. Sewer lines	5. Cess Pool	8. Sewage lagoon	11. Fuel storage	14. Abandon water well	16. Other (specify below)
3. Watertight sewer line	6. Seepage pit	9. Feed yard	12. Fertilizer storage	How many feet? 40 ft plus	
Direction from well? North					

From	To	LITHOLOGIC LOG	From	To	LITHOLOGIC LOG
0	3	topsoil			
3	8	clay			
8	18	fine sand			
18	35	medium sand			

7 Contractor's or Landowner's Certification: This water well was 1. constructed 2. reconstructed or 3. plugged under my jurisdiction and was completed on (mo/day/year) 7/13/18 and this record is true to the best of my knowledge and belief.
Kansas Water Well Contractor's License No. 236 This water well record was completed on (mo/day/year) 7/16/18
under the business name of Harp Well and Pump Service by (signature) Todd S. Harp