


WATER WELL RECORD Form WWC-5 KSA 82a-1212

1 LOCATION OF WATER WELL: Sedgwick FRACTION NE 1/4 NW 1/4 NW 1/4 SECTION NUMBER 4 TOWNSHIP NUMBER T 27 S RANGE NUMBER R 1W E/W

Distance and direction from nearest town or city street address of well if located within city? 3732 N. Pepper Ridge Wichita, Kansas

2 WATER WELL OWNER: KLAUSMEYER CONSTRUCTION RR#,ST. ADDRESS,BOX #: 10008 W. York CITY, STATE: Wichita, Kansas Board of Agriculture, Division of Water Resource Application Number:

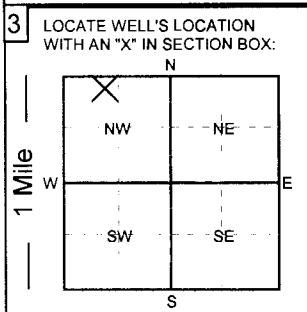

3 LOCATE WELL'S LOCATION WITH AN "X" IN SECTION BOX: 4 DEPTH OF COMPLETED WELL: 55 ft. ELEVATION: WELL'S STATIC WATER LEVEL 12 FT. BELOW LAND SURFACE MEASURED ON mo/day/yr: 12/5/18

5 TYPE OF CASING USED: 1. Steel 2. PVC 3. RPM (SR) 4. ABS 5. Wrought Iron 6. Asbestos-Cement 7. Fiberglass 8. Concrete tile 9. Other (Specify below) CASING JOINTS: Glued Threaded Welded Clamped

6 GROUT MATERIALS: 1. Neat cement 2. Cement Grout 3. Bentonite Other bentonite hole plug Grout intervals: From 4 ft. to 24 ft.

LITHOLOGIC LOG table with columns for From, To, and description. Entries include topsoil (0-3 ft), clay (3-8 ft), fine sand (8-25 ft), and medium sand (25-55 ft).

7 Contractor's or Landowner's Certification: This water well was 1. constructed 2. reconstructed or 3. plugged under my jurisdiction and was completed on (mo/day/year) 12/5/18