

WATER WELL RECORD Form WWC-5


☐ Original Record ☐ Correction ☐ Change in Well Use

Division of Water
Resources App. No.

Well ID

[illegible]

PICK NODE
(FOR PLOTTING

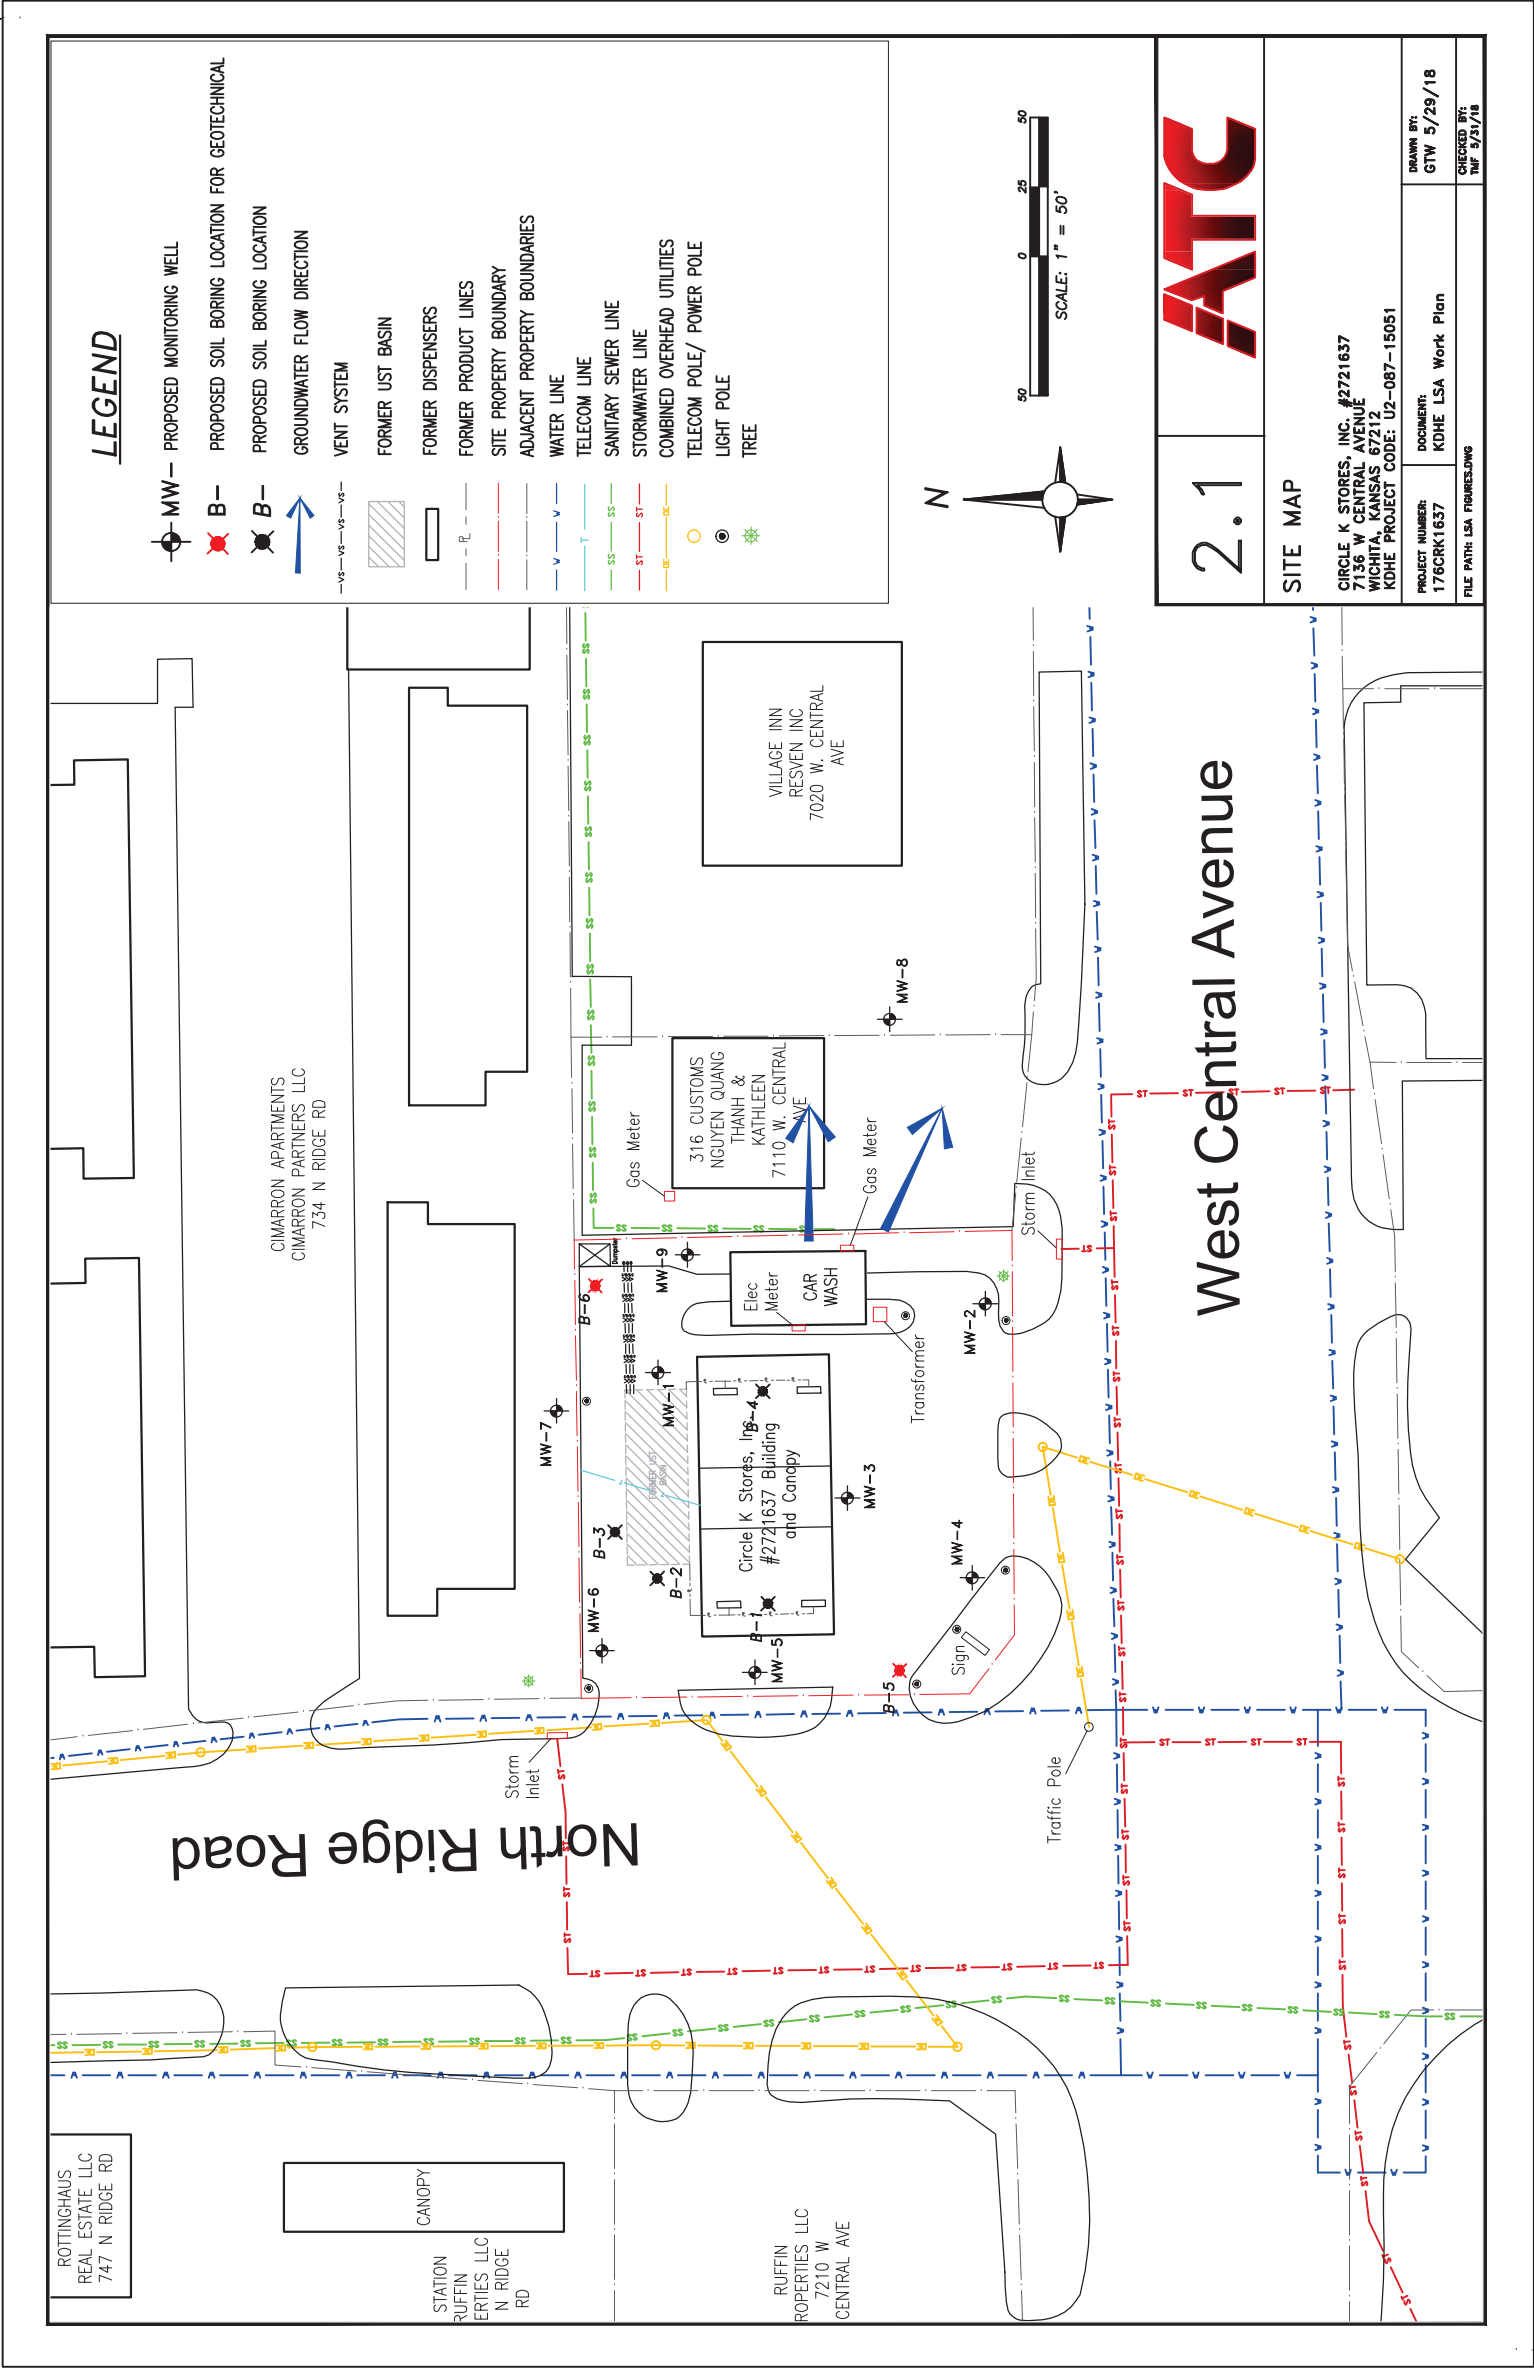

PICK NODE
FOR PLOTTING

VIEW - SHEET

PAPER SIZE: "Ledger" - 11" x 17"
PRINTABLE AREA: 16.75" x 10.75" ON KYOCERA MITA OR ROYAL COPYSTAR
TURN PLOT STAMP ON, GO TO "SETTINGS, LOAD" & USE THE LOWER LEFT VERSION