

**WATER WELL PLUGGING RECORD Form WWC-5P KSA 82a-1212 ID NO.**

MW-3

1 **LOCATION OF WATER WELL:** Fraction 1/4 SW 1/4 SE 1/4 SE 1/4 Section Number 4 Township Number T 27 S Range Number 1  E  W  
 County: Sedgwick


Street/Rural Address of Well Location; if unknown, distance & direction from nearest town or intersection: If at owner's address, check here  7422 W. 21st Street  
Wichita, KS 67205

**Global Positioning Systems (GPS) information:**  
 Latitude: \_\_\_\_\_ (in decimal degrees)  
 Longitude: \_\_\_\_\_ (in decimal degrees)  
 Elevation: 1327.91 TOC  
 Horizontal Datum:  WGS84,  NAD83,  NAD27  
 Collection Method: \_\_\_\_\_

2 **WATER WELL OWNER:** AAA Rentall  
 RR#, St. Address, Box #: PO Box 17336  
 City, State ZIP Code: Wichita, KS 67217

GPS unit (Make/Model: \_\_\_\_\_)  
 Digital Map/Photo,  Topographic Map,  Land Survey  
 Est. Accuracy:  < 3 m,  3-5 m,  5-15 m,  > 15 m

3 **MARK WELL'S LOCATION WITH AN "X" IN SECTION BOX:**

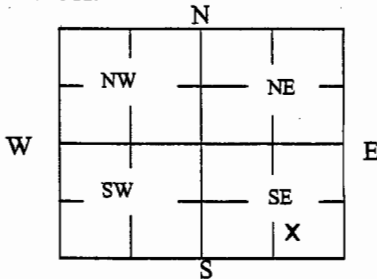

4 **DEPTH OF WELL** 19.54 ft.  
**WELL'S STATIC WATER LEVEL** 14.09 ft

WELL WAS USED AS:

- Domestic
- Public Water Supply
- Dewatering
- Irrigation
- Oil Field Water Supply
- Monitoring
- Feedlot
- Domestic (Lawn & Garden)
- Injection Well
- Industrial
- Air Conditioning
- Other \_\_\_\_\_

Was a chemical/bacteriological sample submitted to Department? Yes  No

5 **TYPE OF BLANK CASING USED:**

- Steel
- RMP (SR)
- Wrought
- Fiberglass
- Other (Specify below) \_\_\_\_\_
- PVC
- ABS
- Asbestos-Cement
- Concrete Tile

Blank casing diameter 2 in. Was casing pulled? Yes  No  If yes, how much 3 ft  
 Casing height above or below land surface 36 in.

6 **GROUT PLUG MATERIAL:**  Neat cement  Cement grout  Bentonite  Other \_\_\_\_\_

Grout Plug Intervals: From 3 ft. to 19.54 ft., From \_\_\_\_\_ ft. to \_\_\_\_\_ ft., From \_\_\_\_\_ ft. to \_\_\_\_\_ ft.


What is the nearest source of possible contamination:

- Septic tank
  - Seepage pit
  - Fuel storage
  - Other (specify below) \_\_\_\_\_
  - Sewer lines
  - Pit privy
  - Fertilizer storage
  - Watertight sewer lines
  - Sewage lagoon
  - Insecticide storage
  - Lateral lines
  - Feedyard
  - Abandoned water well
  - Cess pool
  - Livestock pens
  - Oil well/Gas well
- Direction from well? NW  
 How many feet? 30

FROM	TO	PLUGGING MATERIALS	FROM	TO	PLUGGING MATERIALS
0	0.5	Asphalt			
0.5	3	Compacted silt/clay			
3	19.54	Hydrated Bentonite chips			
					Trust Fund: AAA Rent All
					U2-087-11781

7 **CONTRACTOR'S OR LANDOWNER'S CERTIFICATION:** This water well was plugged under my jurisdiction and was completed on (mo/day/year) 7/30/19 and this record is true to the best of my knowledge and belief. Kansas Water Well Contractor's License No. 585. This Water Well Record was completed on (mo/day/year) 8/1/19 under the business name of Associated Environmental, Inc. by (signature) \_\_\_\_\_

Send one white copy to Kansas Department of Health & Environment, Geology Section, 1000 SW Jackson Street, Ste. 420, Topeka, KS 66612-1367. Send one copy to WATER WELL OWNER and retain one for your records.  
 Visit us at <http://www.kdheks.gov/waterwell/index.html> Telephone 785-296-5524.

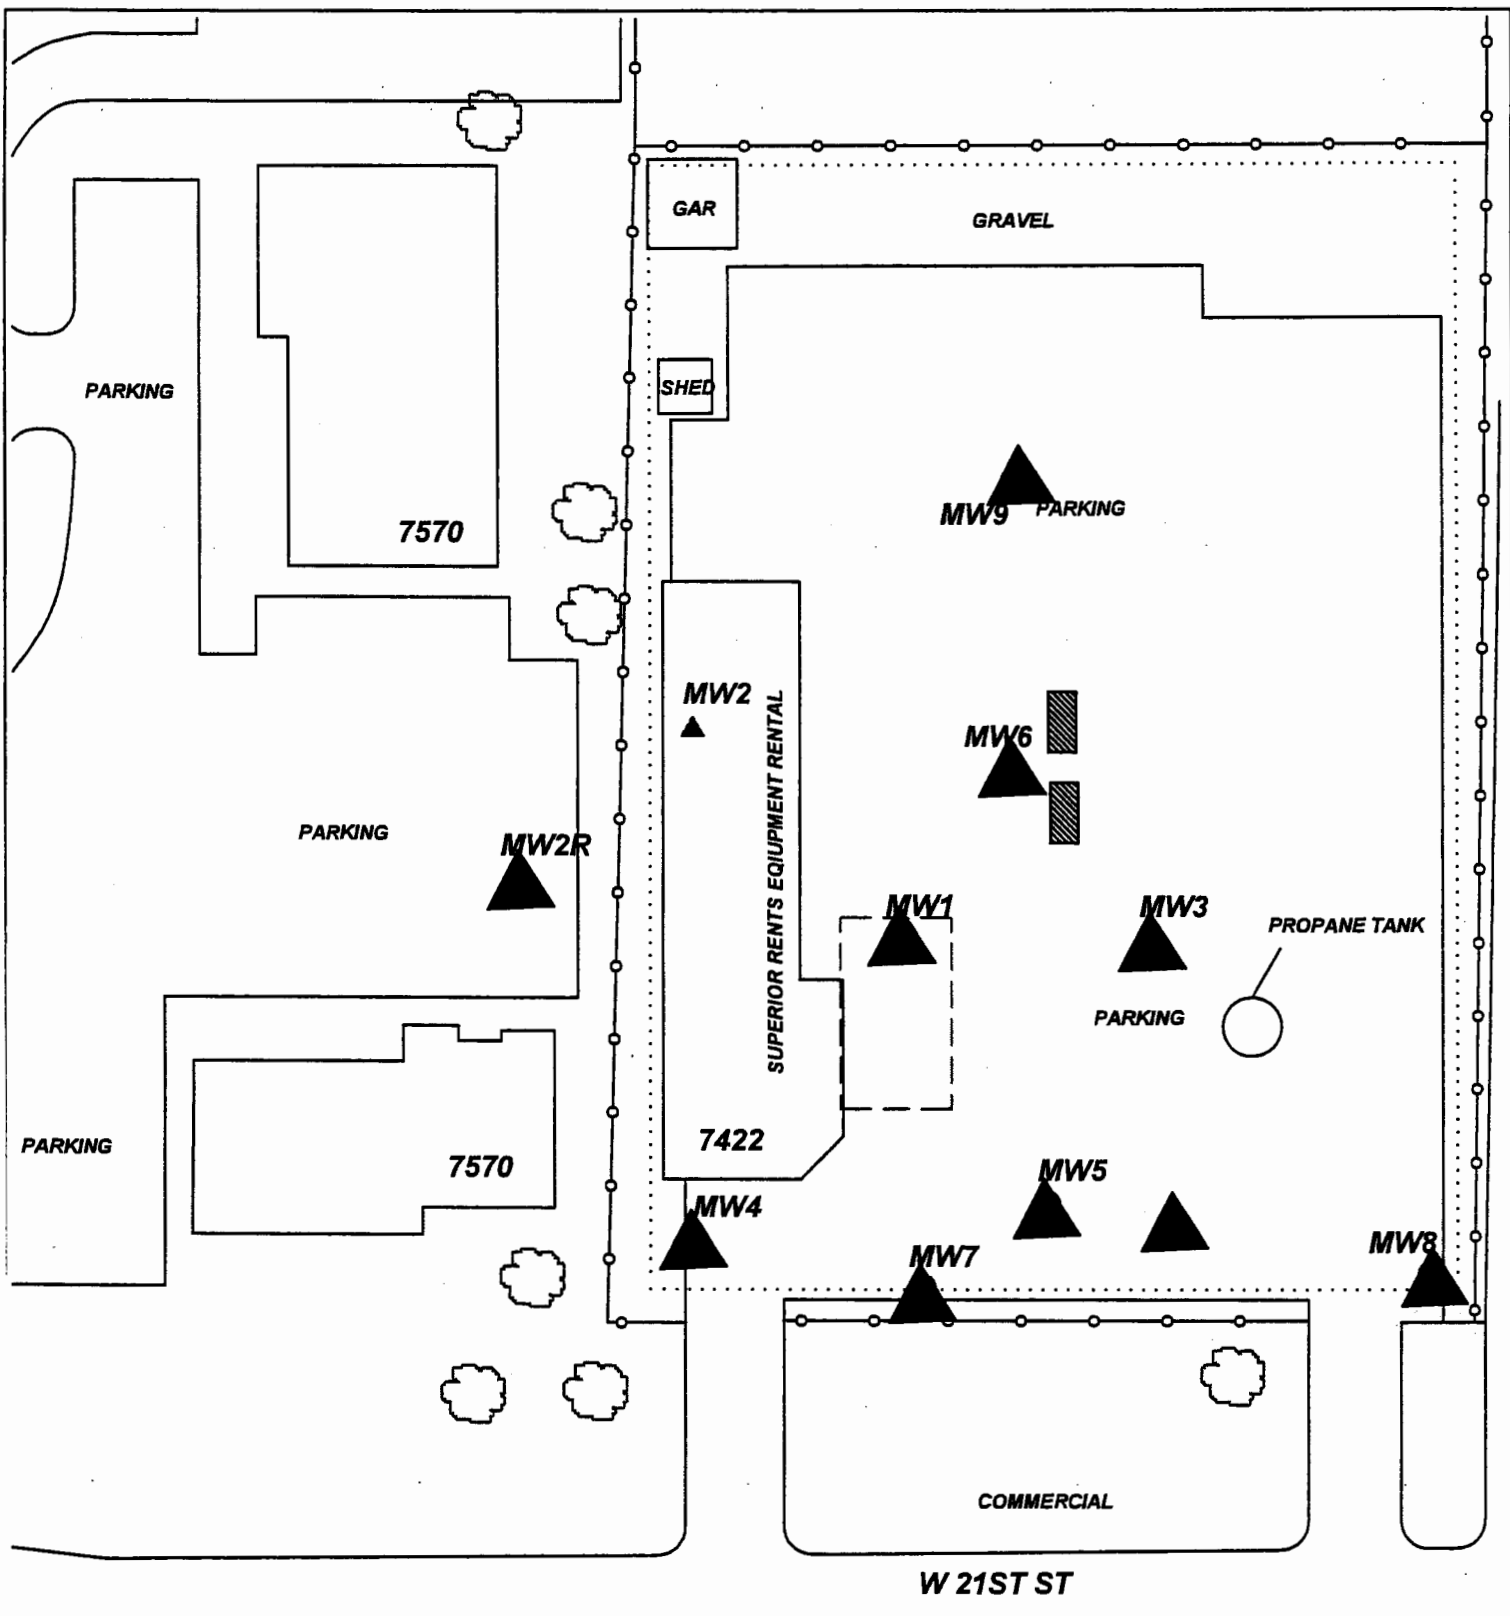

PROJECT: **AAA RENT ALL**

ADDRESS: **7422 W. 21ST. ST**

LOCATION: **WICHITA, KS**

DRAWN BY: **B. STALNAKER** DATE: **4/26/18**


REVISED BY: **C. ROE** DATE: **3/6/19**

AEI JOB #: **TF284.** KONE JOB #: **U2-087-11781**

TITLE:

**AEI ASSOCIATED ENVIRONMENTAL INC.**

- LEGEND:
- = FORMER TANK BASIN
  - = CURRENT 400G GAS, 600 G DIESEL ASTs
  - = MONITORING WELL
  - = PLUGGED/DESTROYED WELL
  - = SUBJECT PROPERTY

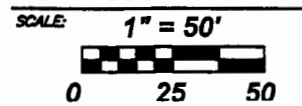

NOTES:  
No basements observed within 500'.