

**WATER WELL RECORD      Form WWC-5**☐ Original Record    ☐ Correction    ☐ Change in Well Use

Division of Water  
Resources App. No.

Well ID

[illegible]

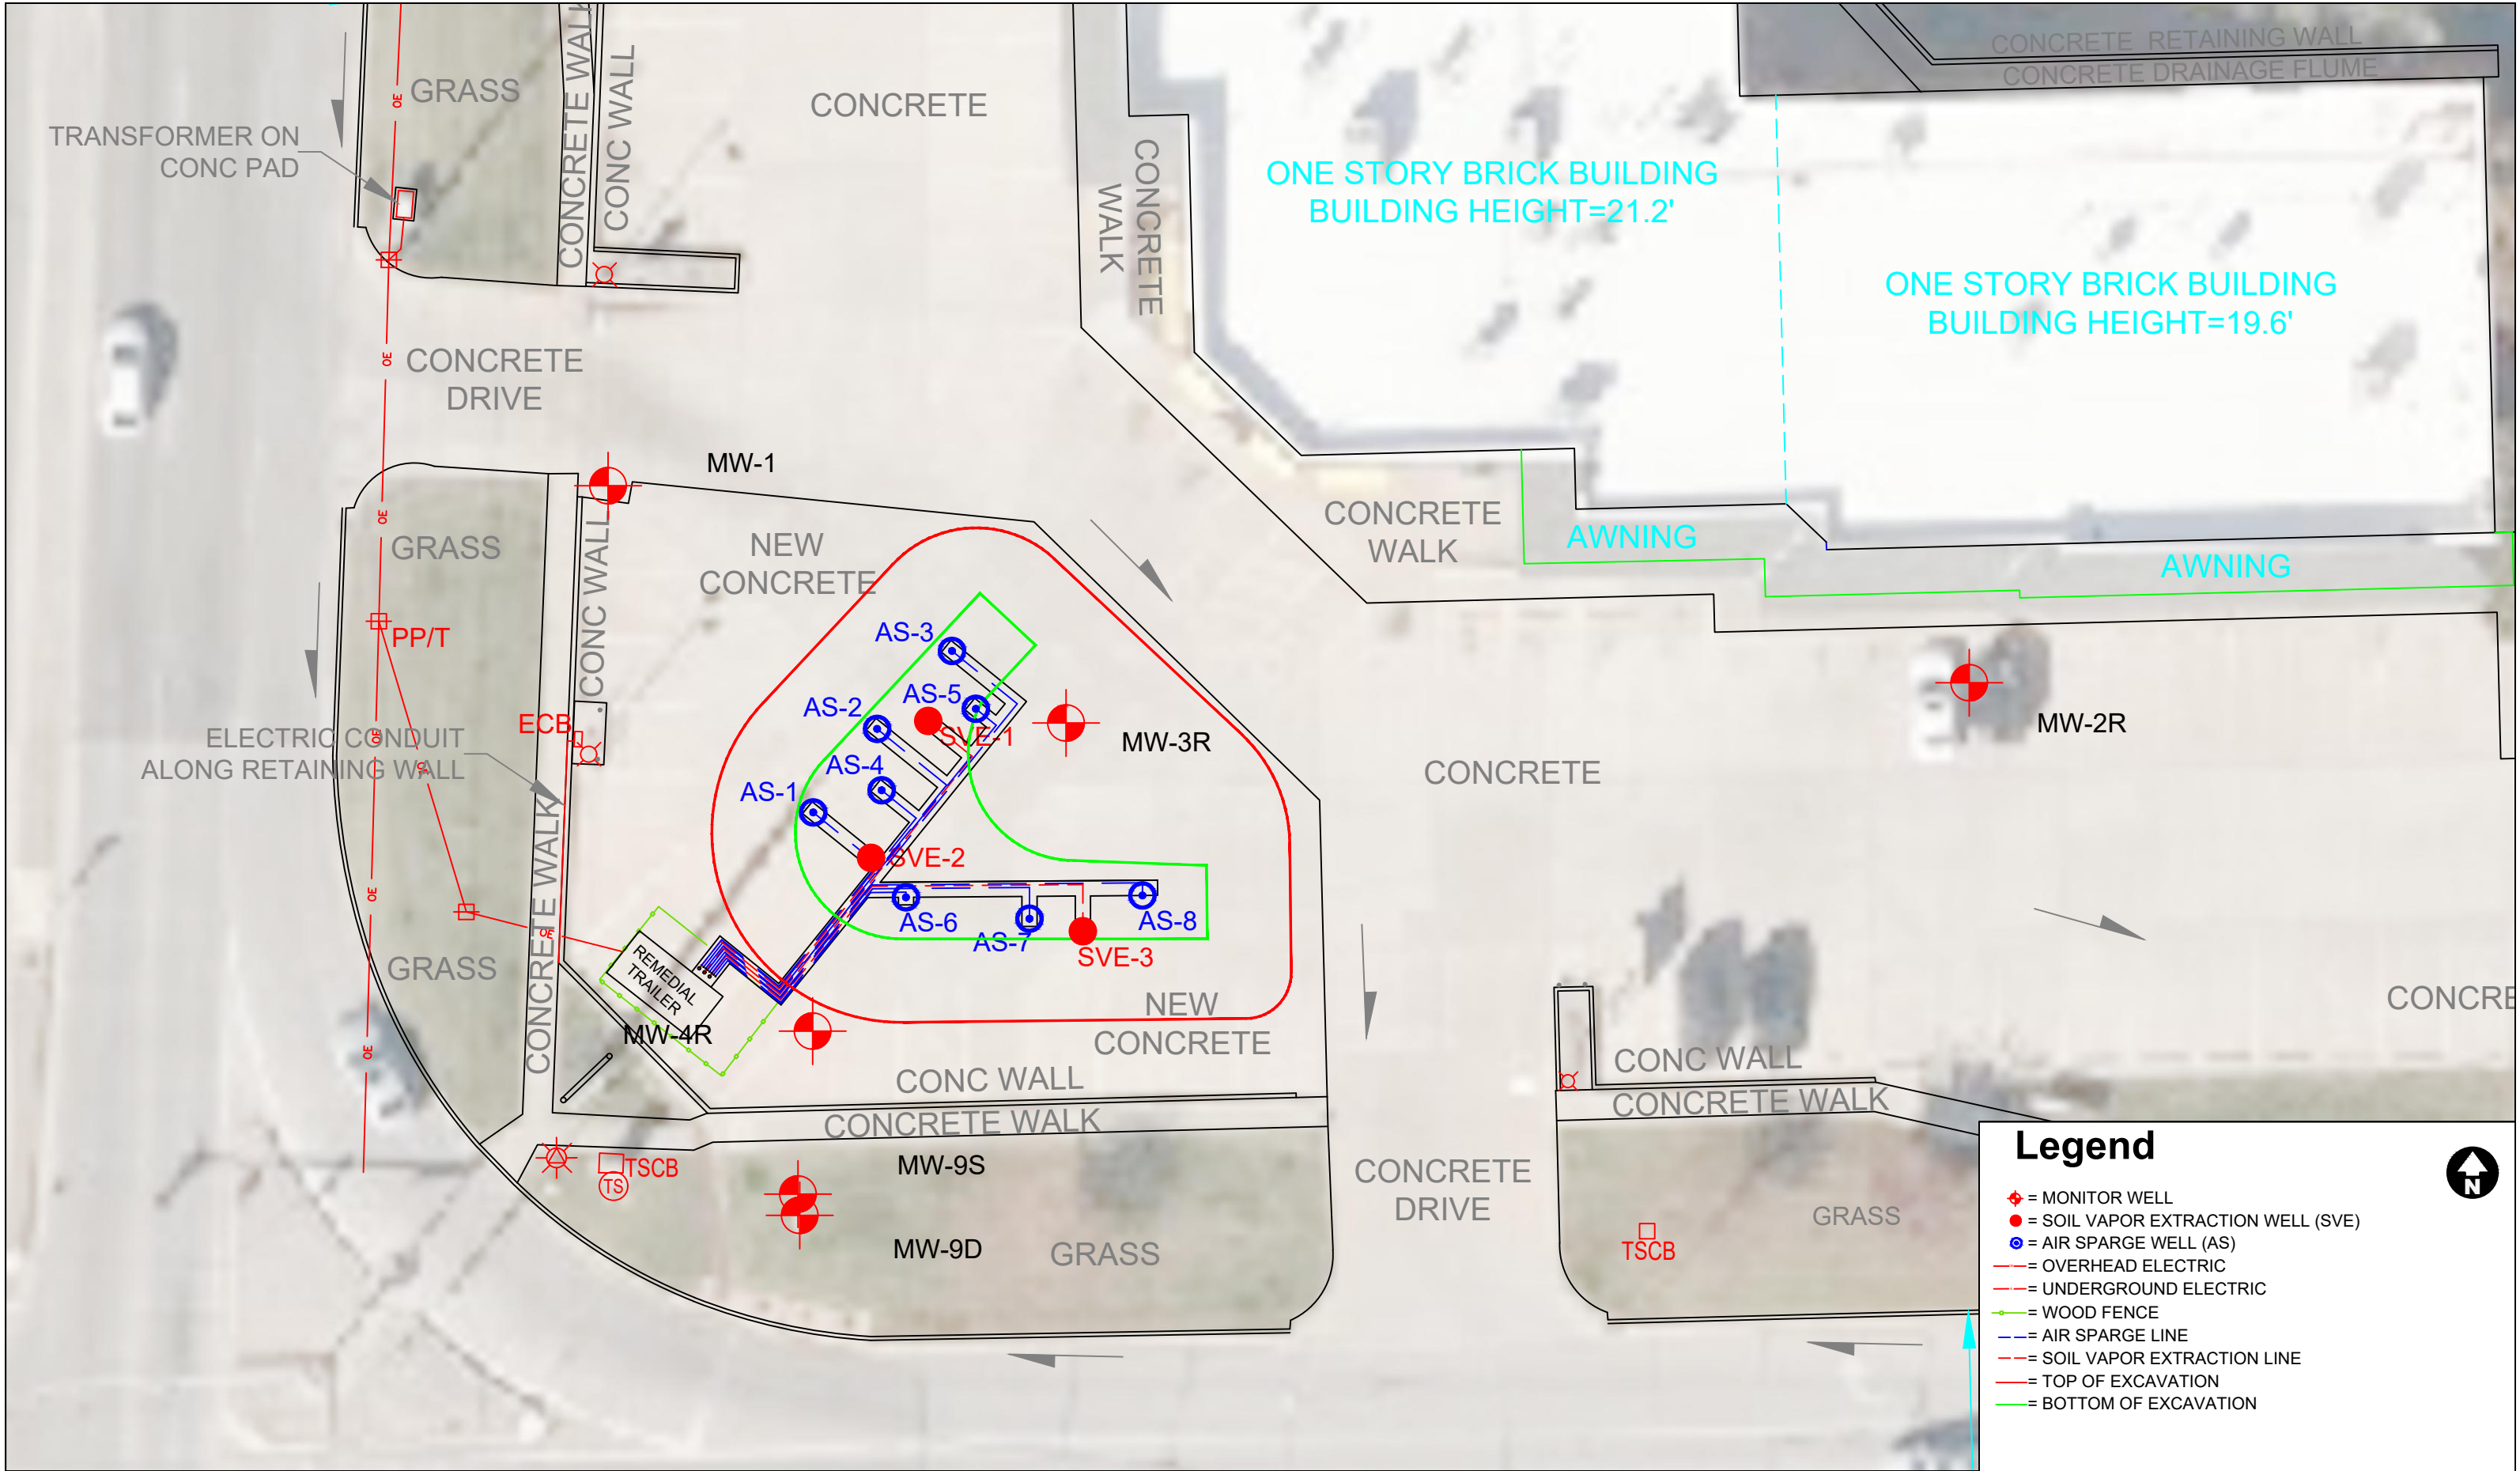


	FIGURE: <b>1B</b>	FIGURE NAME: <b>SITE BASE MAP - CLOSE UP</b>	Coastal Mart #7301 10330 West Central Wichita, Kansas KDHE CODE: U2-087-13357	 SCALE: 1" = 20'	All locations are approximate
	DATE: <b>11/17/19</b>	PROJECT NUMBER: <b>1874117</b>			
	DRAWN BY: <b>SGE</b>	PROJECT MANAGER: <b>SGE</b>			