


WATER WELL RECORD Form WWC-5

☐ Original Record ☐ Correction ☐ Change in Well Use

Division of Water
Resources App. No.

Well ID

[illegible]

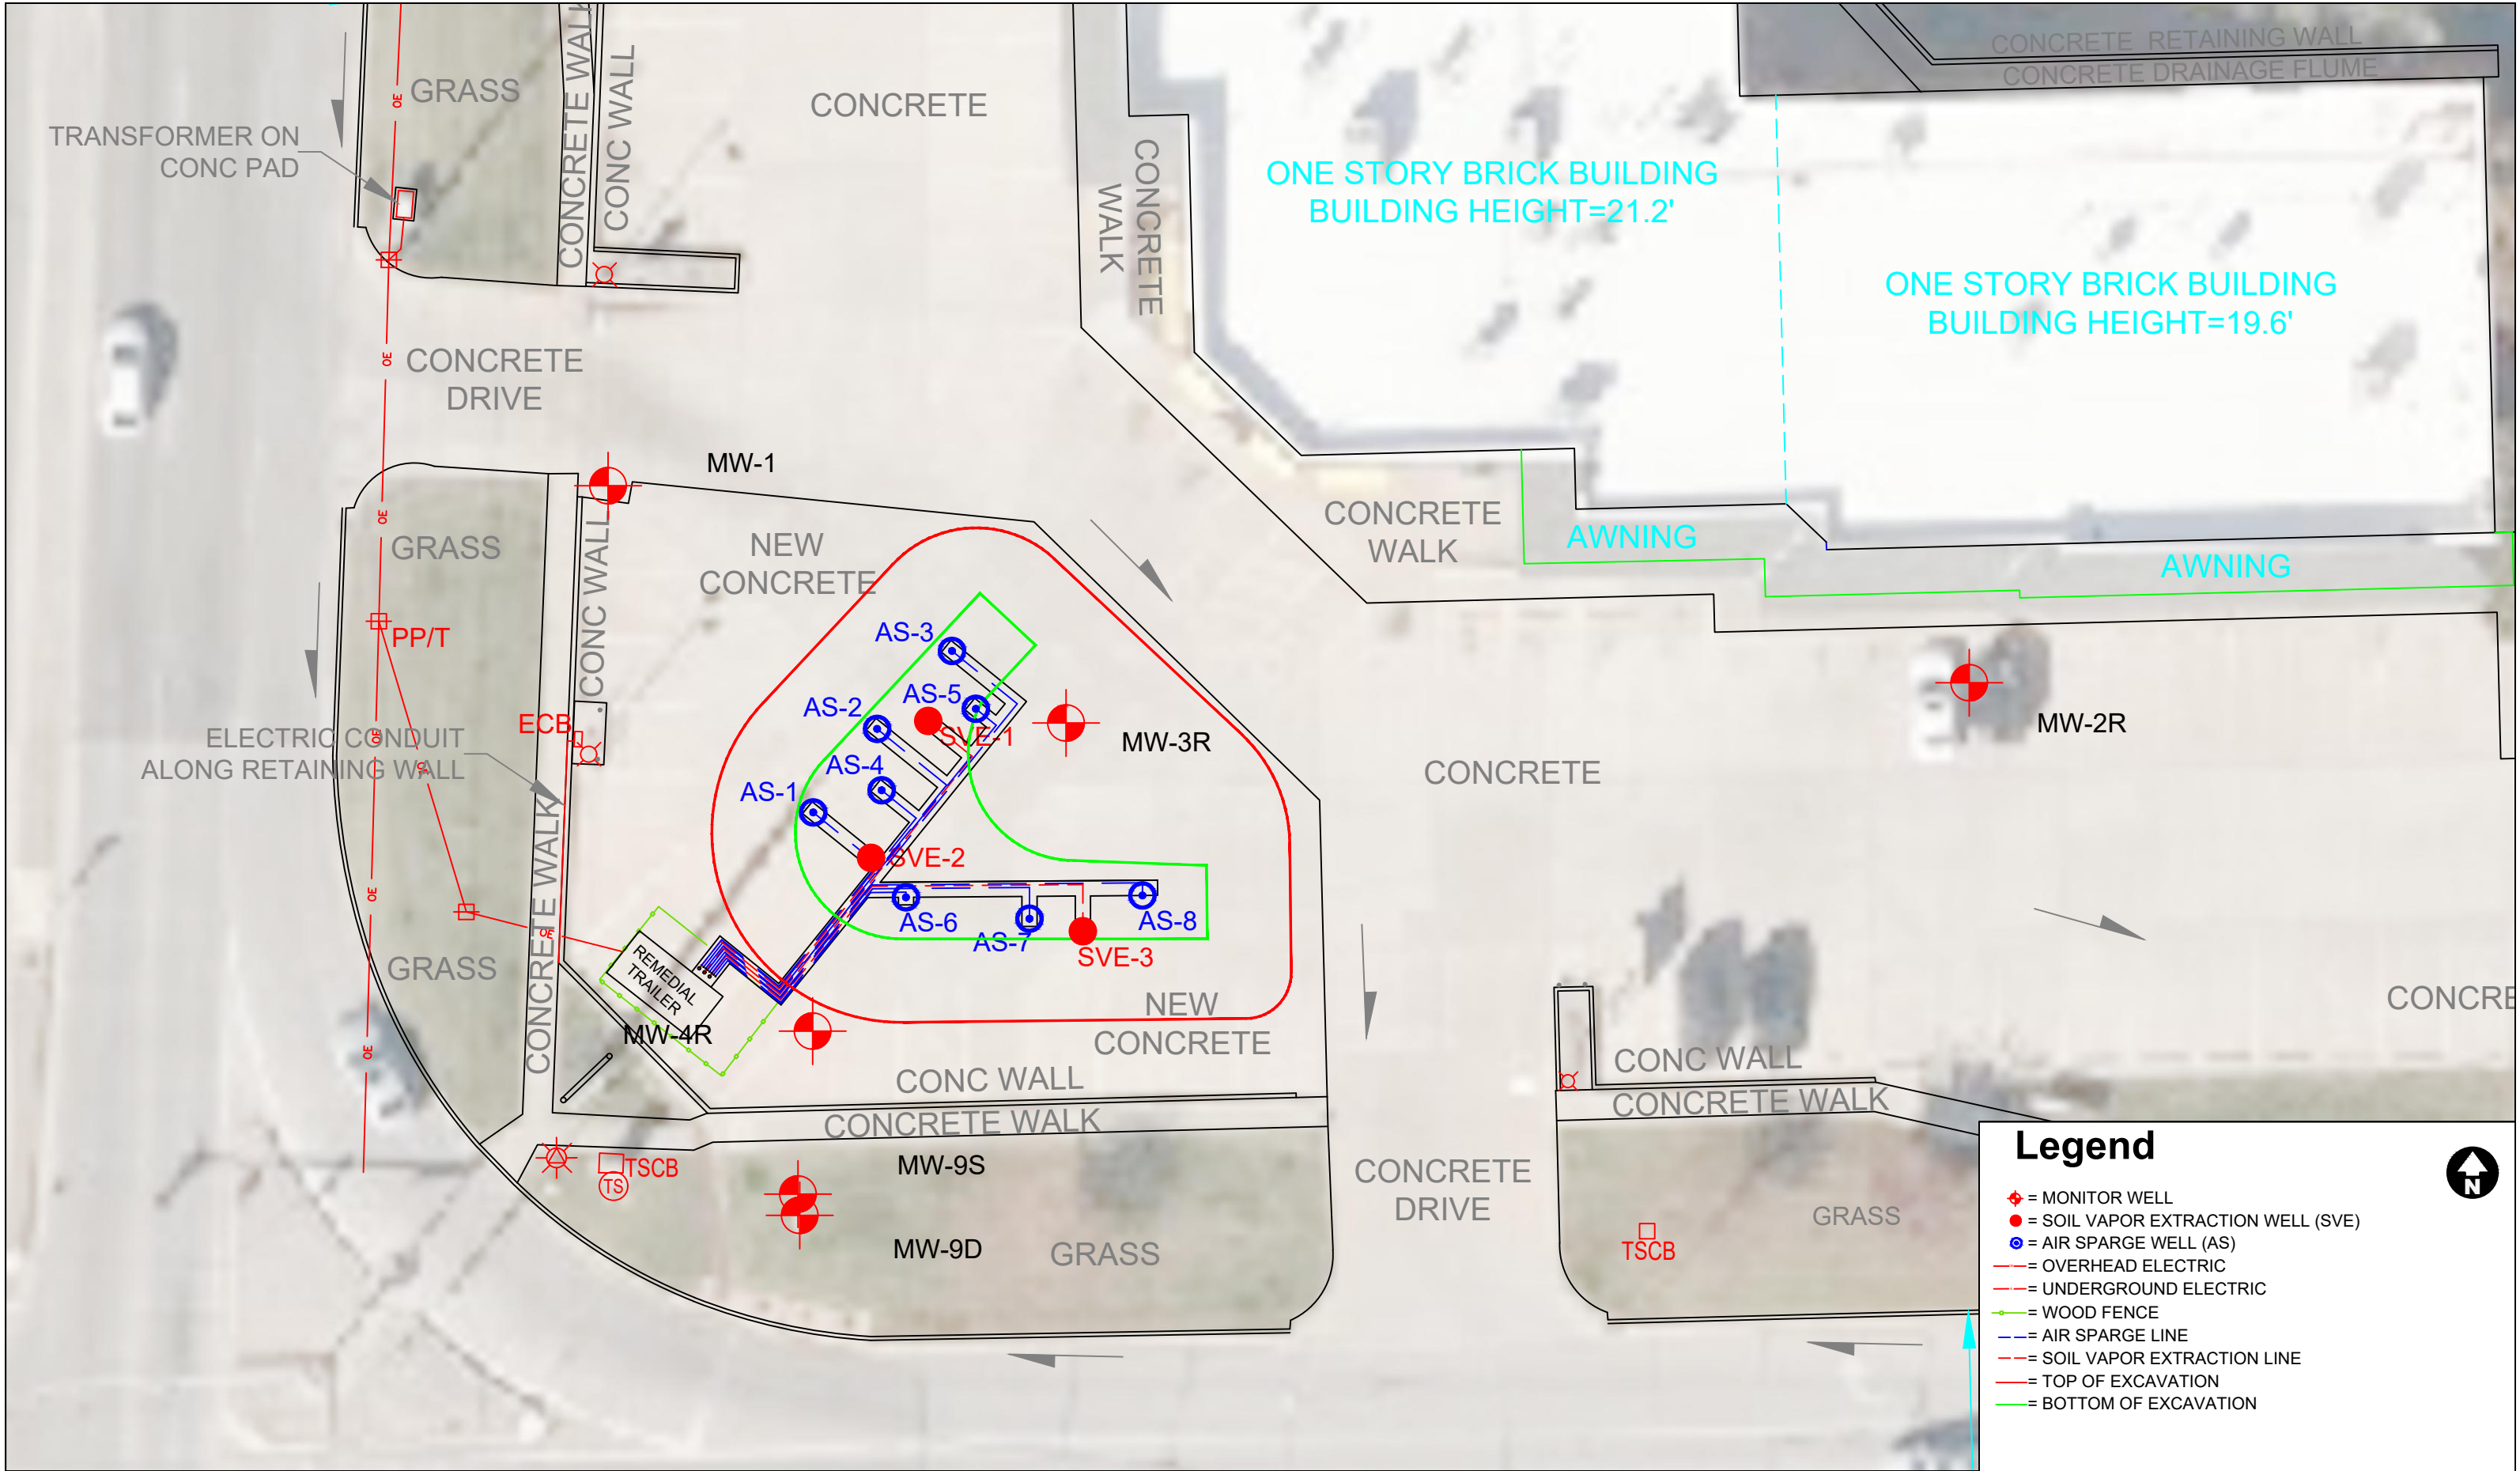

| | | | | | |
|--|-----------------------|--|--|---------------------|---------------------------------------|
| | FIGURE: 1B | FIGURE NAME: SITE BASE MAP - CLOSE UP | Coastal Mart #7301 10330 West Central Wichita, Kansas KDHE CODE: U2-087-13357 | SCALE: 1" = 20' | All locations are approximate |
| | DATE: 11/17/19 | PROJECT NUMBER: 1874117 | | | |
| | DRAWN BY: SGE | PROJECT MANAGER: SGE | | | |