


**WATER WELL RECORD      Form WWC-5**

☐ Original Record    ☐ Correction    ☐ Change in Well Use

Division of Water  
Resources App. No.

Well ID

[illegible]

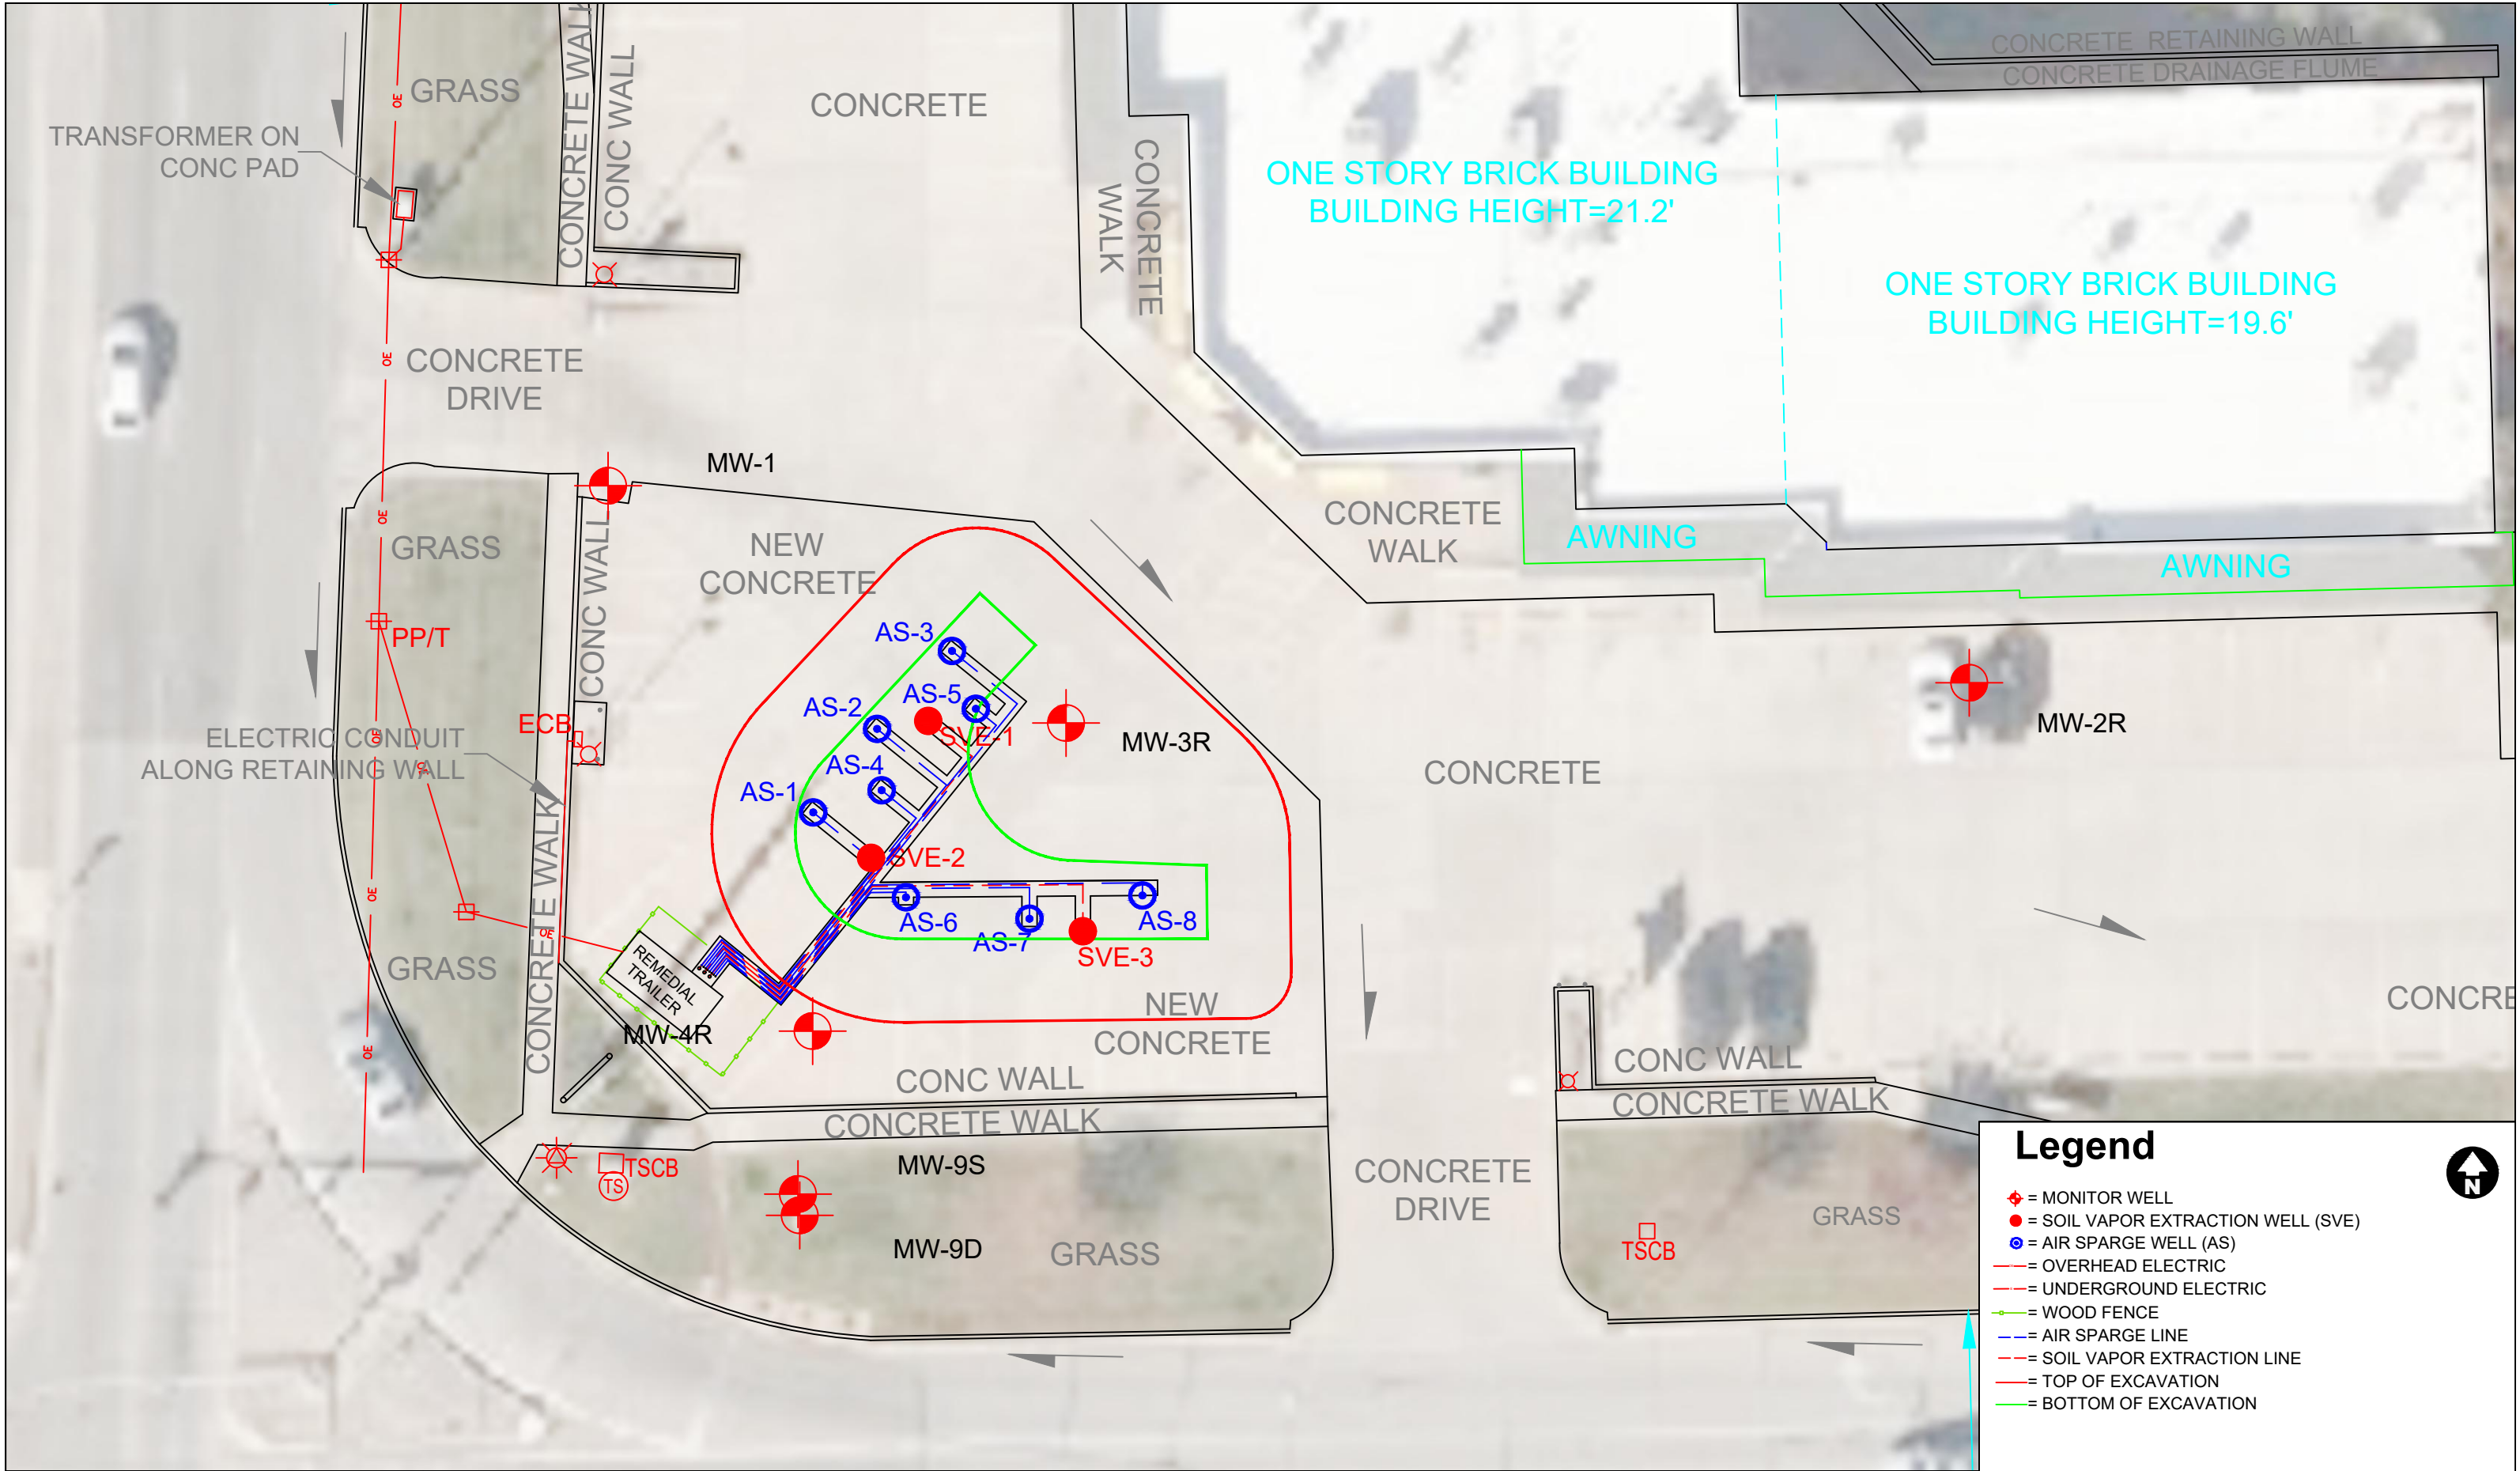

Legend

- ◆ = MONITOR WELL
- = SOIL VAPOR EXTRACTION WELL (SVE)
- ⊙ = AIR SPARGE WELL (AS)
- = OVERHEAD ELECTRIC
- - - = UNDERGROUND ELECTRIC
- = WOOD FENCE
- = AIR SPARGE LINE
- - - = SOIL VAPOR EXTRACTION LINE
- = TOP OF EXCAVATION
- = BOTTOM OF EXCAVATION



FIGURE: 1B

FIGURE NAME:

SITE BASE MAP - CLOSE UP

DATE: 11/17/19

PROJECT NUMBER:

1874117

DRAWN BY: SGE

PROJECT MANAGER:

SGE

Coastal Mart #7301  
10330 West Central  
Wichita, Kansas  
KDHE CODE: U2-087-13357



SCALE: 1" = 20'

All locations are approximate