

WATER WELL RECORD Form WWC-5

☐ Original Record ☐ Correction ☐ Change in Well Use

Division of Water
Resources App. No.

Well ID

[illegible]

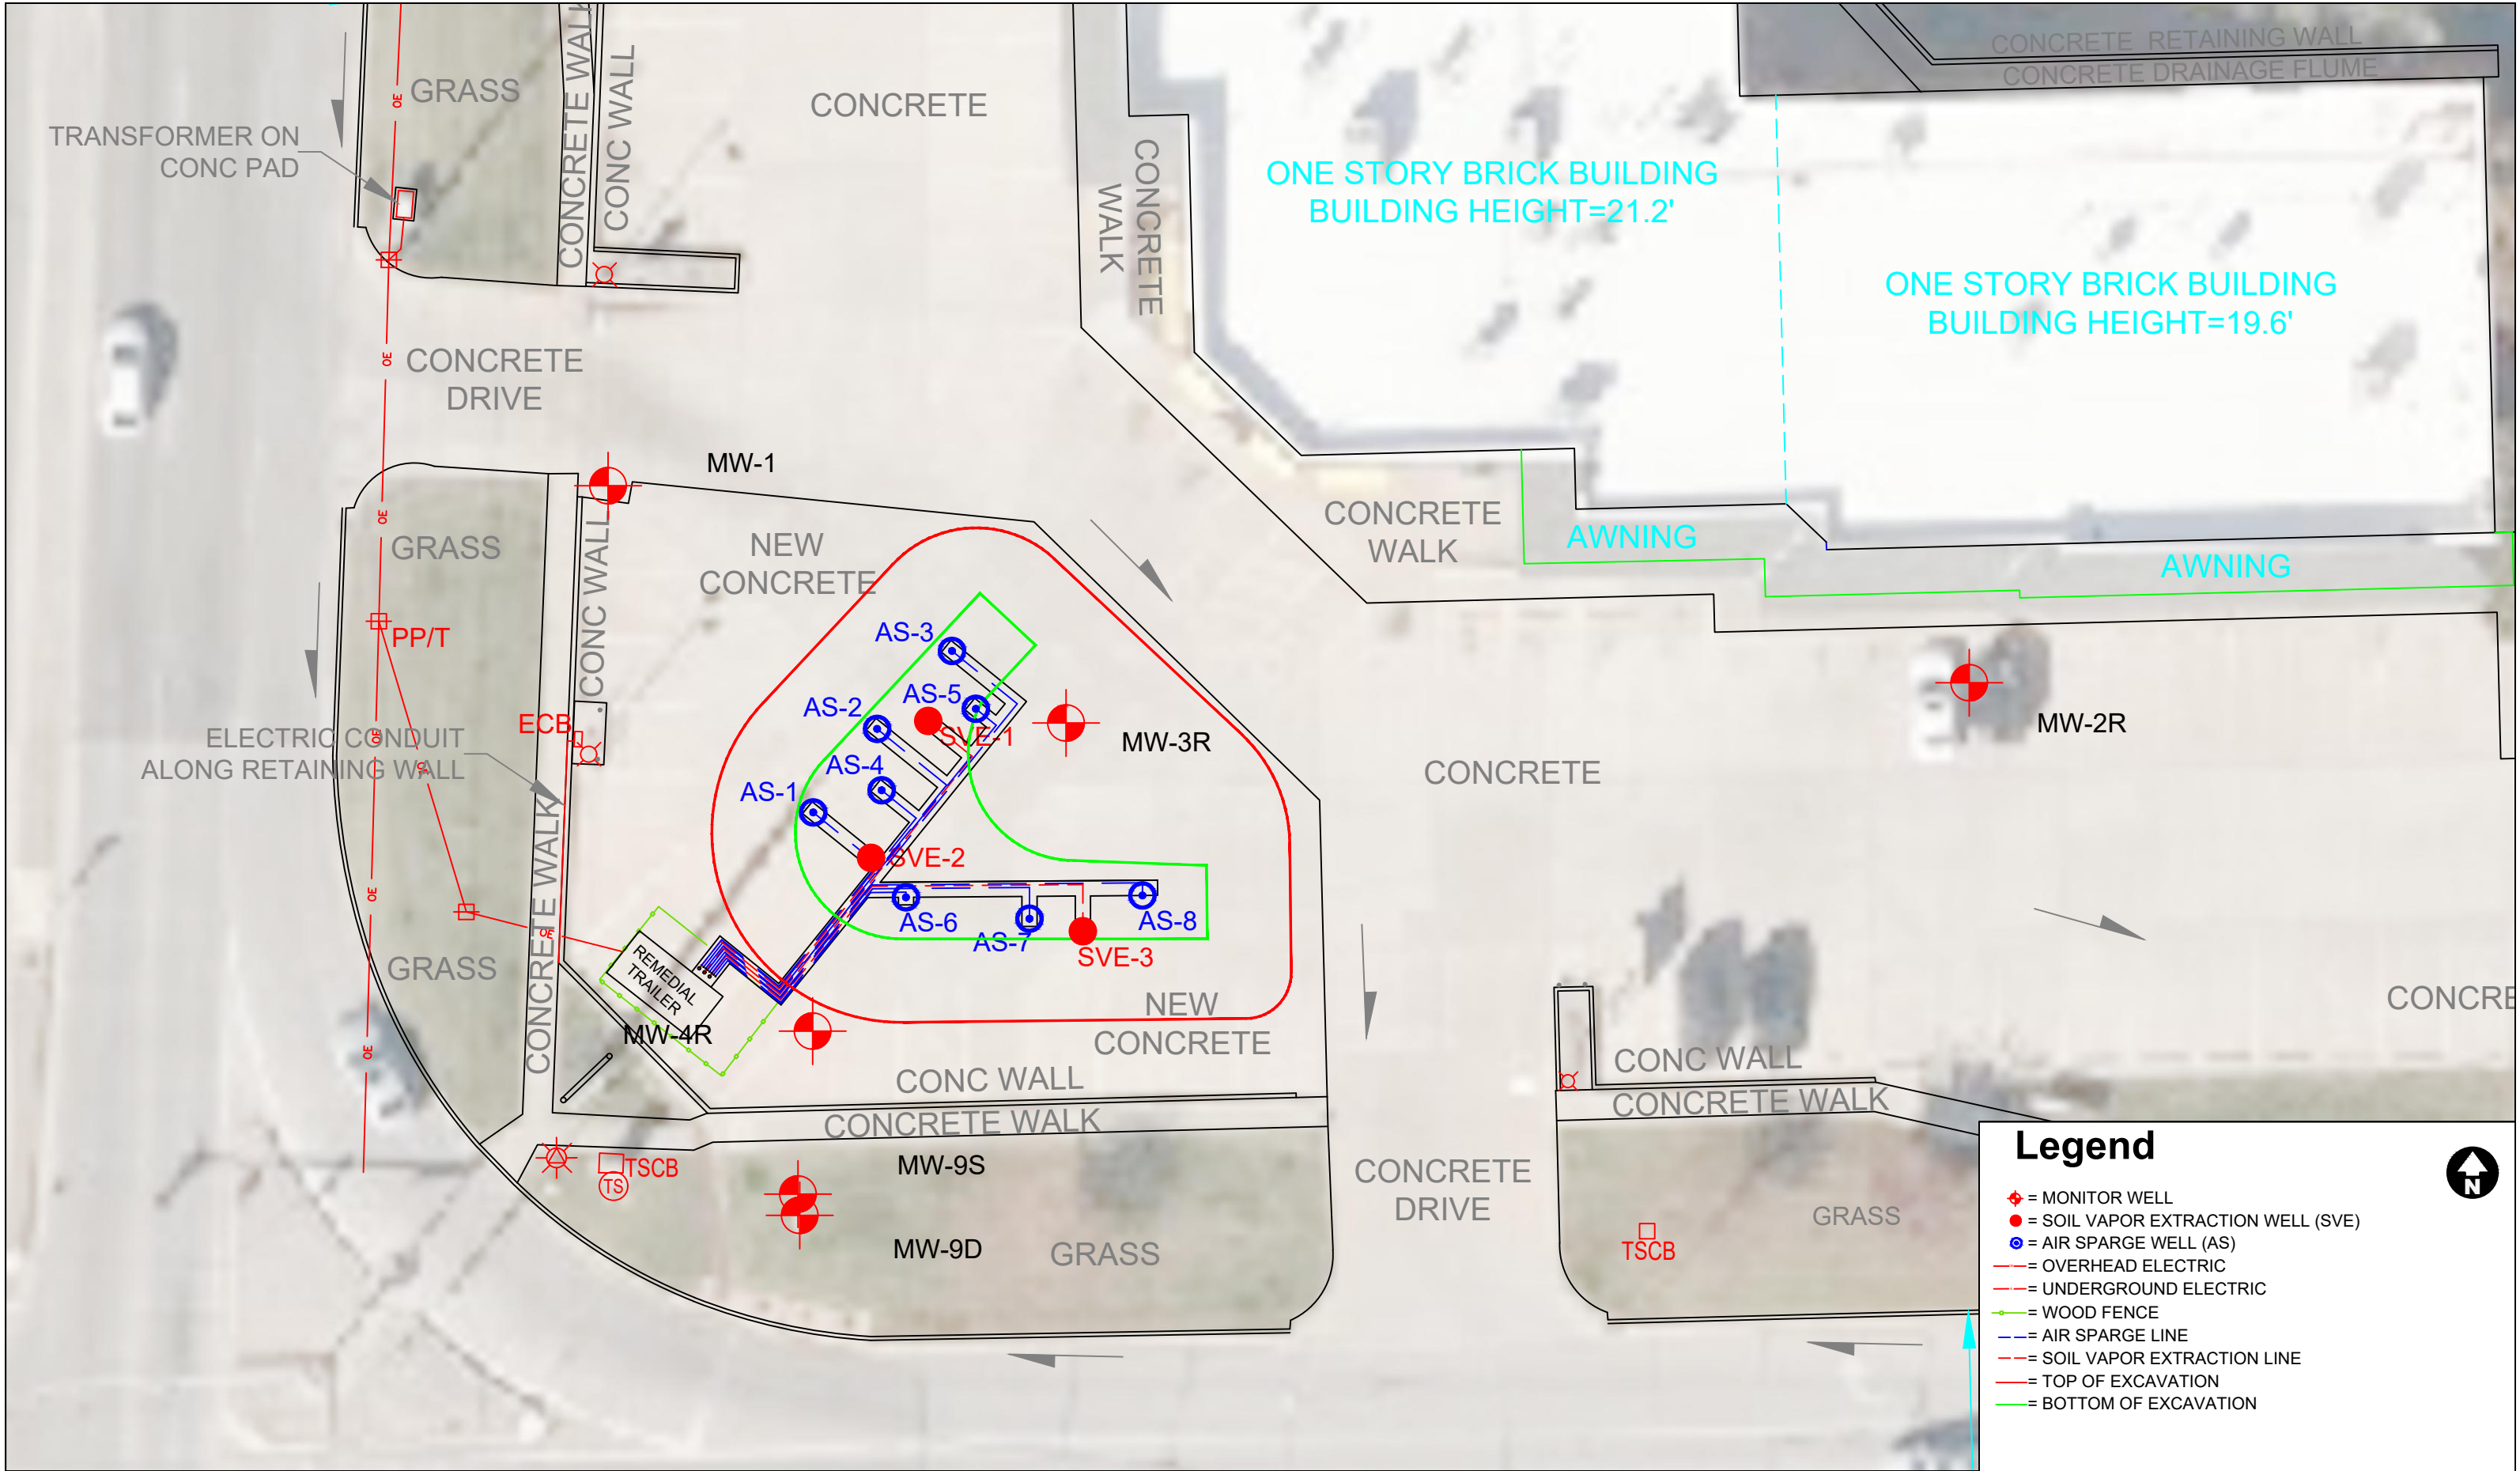


	FIGURE: 1B	FIGURE NAME: SITE BASE MAP - CLOSE UP	Coastal Mart #7301 10330 West Central Wichita, Kansas KDHE CODE: U2-087-13357	 SCALE: 1" = 20'	All locations are approximate
	DATE: 11/17/19	PROJECT NUMBER: 1874117			
	DRAWN BY: SGE	PROJECT MANAGER: SGE			